

GOVERNMENT CORNER RESTORATION FORM

Date: 4-23-1999 By: JC

Township 25S Range 5W Sec. 30

County DOUGLAS

This survey consists of:

State OK Date 3-11-99

No. 100240.005 Narrative:

700240.006 Corner Rpt: 66/8-22

Corner Designation

1/4 S25 | S30

DOUGLAS COUNTY

Condition Report Only

Not Found

Renewed

Unrecorded

Surveyed In

Referenced Out

Previous Renewals 1960 + 1963 OCS

Monument(s) Found: (Condition and Source)

2 1/2" BRASS CAP ON A 1 1/2" O.D. IRON PIPE PROTRUDS 12" ABOVE GROUND 1960

MONUMENT DETAIL

COUNTY SURVEYORS OFFICE T 25S

R 6 W S25 | S30 R 5 W 1/4

1960

Accessories Found:

6" NOW 12" DIA. W. OAK WITH A FULLY HEALED SINGLE BLAZE BEARS N20°W, 66.01 FT (AGREES WITH REC.) 1963

9" NOW 14" DIA W. OAK WITH AN UNHEALED SINGLE ROTTED BLAZE NO SCRIBING VISIBLE BEARS N20 1/2° E, 58.1 FT (AGREES WITH REC.) 1963

CV

RENEWAL

Monument Set (Procedure and Description)

Monument Detail

NONE


N/A

New Accessories

7" MAORONE BARK SCRIBED " 1/4 S 25 CS BT " BEARS
S 35° W, 10.0 FT

19" D. FIR DOUBLE BLAZED AND SCRIBED " 1/4 S 30 CS BT "
BEARS N 53° E, 12.2 FT

Sketch of Monument, Aecessories, and General Area

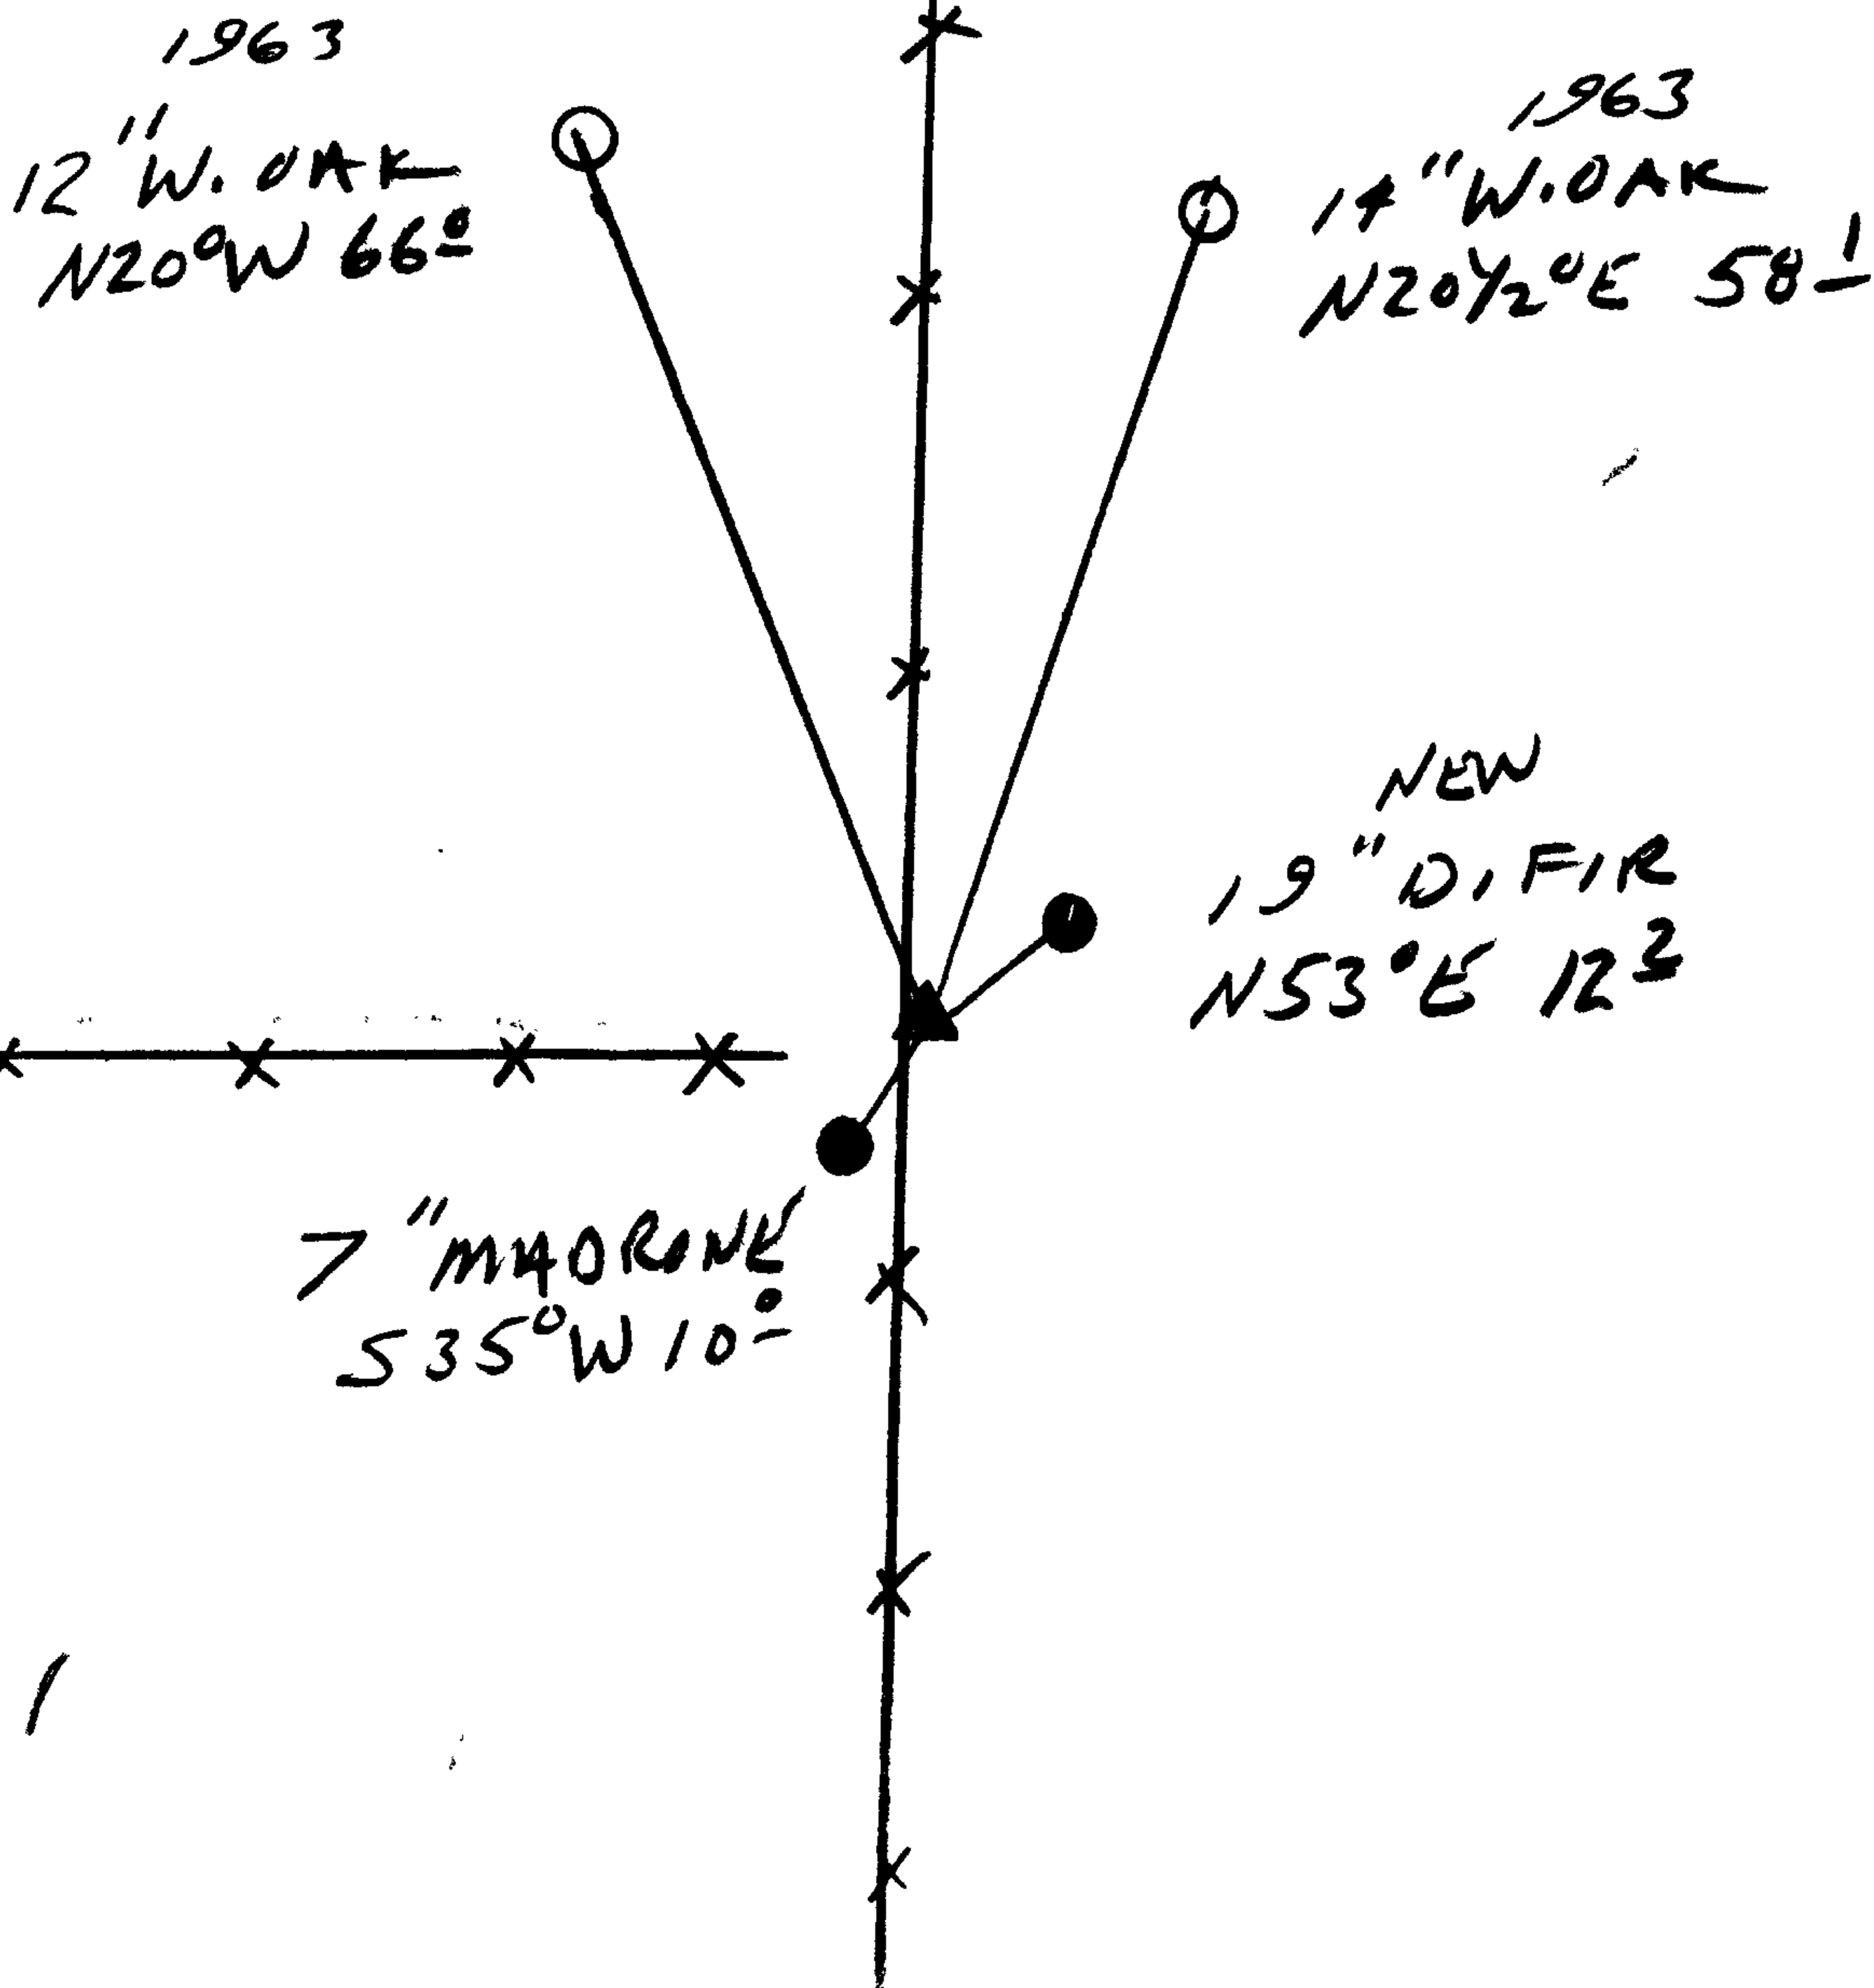


Location & Comments

CORNER LIES 1/2 FT
EAST OF A N-S
FENCE LINE, REMAINS
OF AN OLD FENCE
RUNNING WEST

Comp. Declin. 17 3/4° E
Agency DCS
Party Chief RANDALL W. SMITH
Notekeeper [Signature]
Witnesses STEPHEN J. FLANSE

Address

Surveyor's Seal

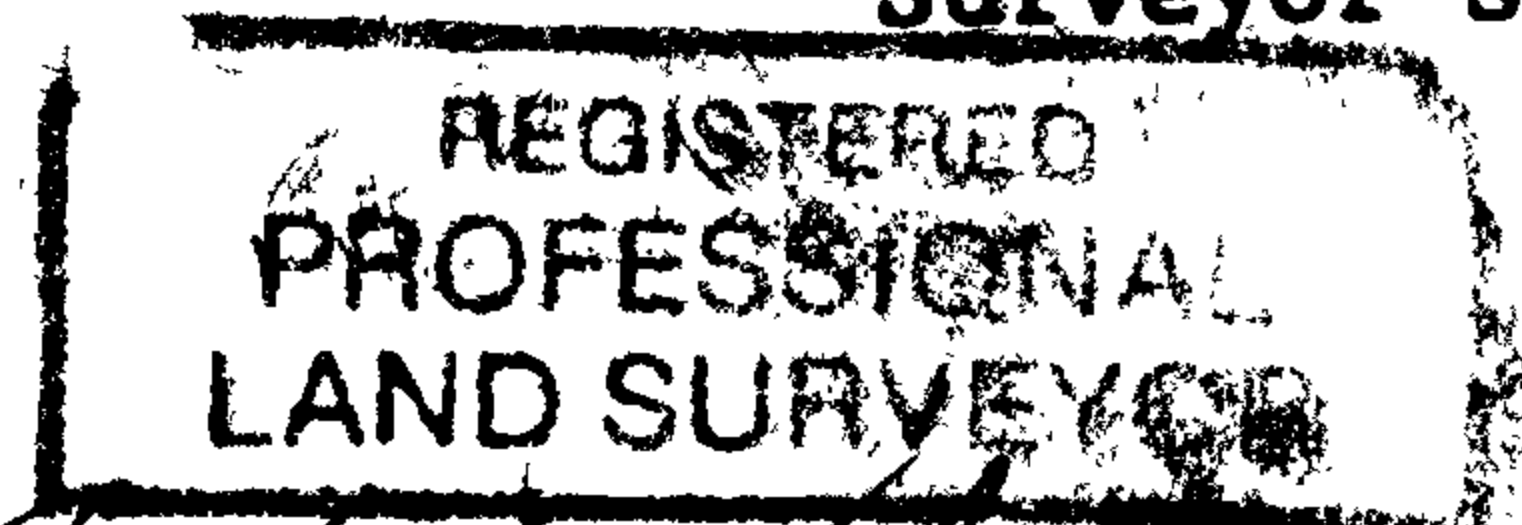

[Signature] BEARS 6-30-2000

