

GOVERNMENT CORNER RESTORATION FORM

Date: 4-23-1999 By: JC

Township 30S Range 3W Sec. 28

County DOUGLAS

This survey consists of:

State OK

Date 3-24-99

No. 037050.044

Map: _____

Narrative: _____

Corner Rpt: 66/8-23

Corner Designation

E NE
DLC 37

- DOUGLAS COUNTY
- Condition Report Only
- Not Found
- Renewed
- Unrecorded
- Surveyed In
- Referenced Out

Previous Renewals 1918 DCSO, 1953 MARKHAM

Monument(s) Found: (Condition and Source)

NONE

MONUMENT DETAIL

N/A

Accessories Found:

NO OBJ'S FOUND

16" NOW 24" DIA. B. OAK WITH A FULLY HEALED DOUBLE BLAZE, BEARS S56°W, 191.8 FT (A GREYS WITH REC.) 1953

12" NOW 21" DIA. W. OAK WITH A FULLY HEALED DOUBLE BLAZE, BEARS S16°W, 170.0 FT (REC S14°W, 170.0 FT) 1953

RENEWAL

Monument Set (Procedure and Description)

2 5/8" DIA BRASS CAP ON A 1 3/8" O.D. IRON PIPE IS SET AT A POSITION DETERMINED BY 1953 BT'S, PROTRUDES 6" ABOVE GROUND, SURROUNDED BY A MOUND OF STONE.

Monument Detail

DOUGLAS COUNTY SURVEYORS T 30 S


NNE
DLC 37
R
4
W

1999 OFFICE

New Accessories

9" W. OAK DOUBLE BLAZED AND SCRIBED "NNE DLC 37 CS BT" BEARS SOUTH, 81.1 FT
~~81.1 FT~~

Sketch of Monument, Accessories, and General Area

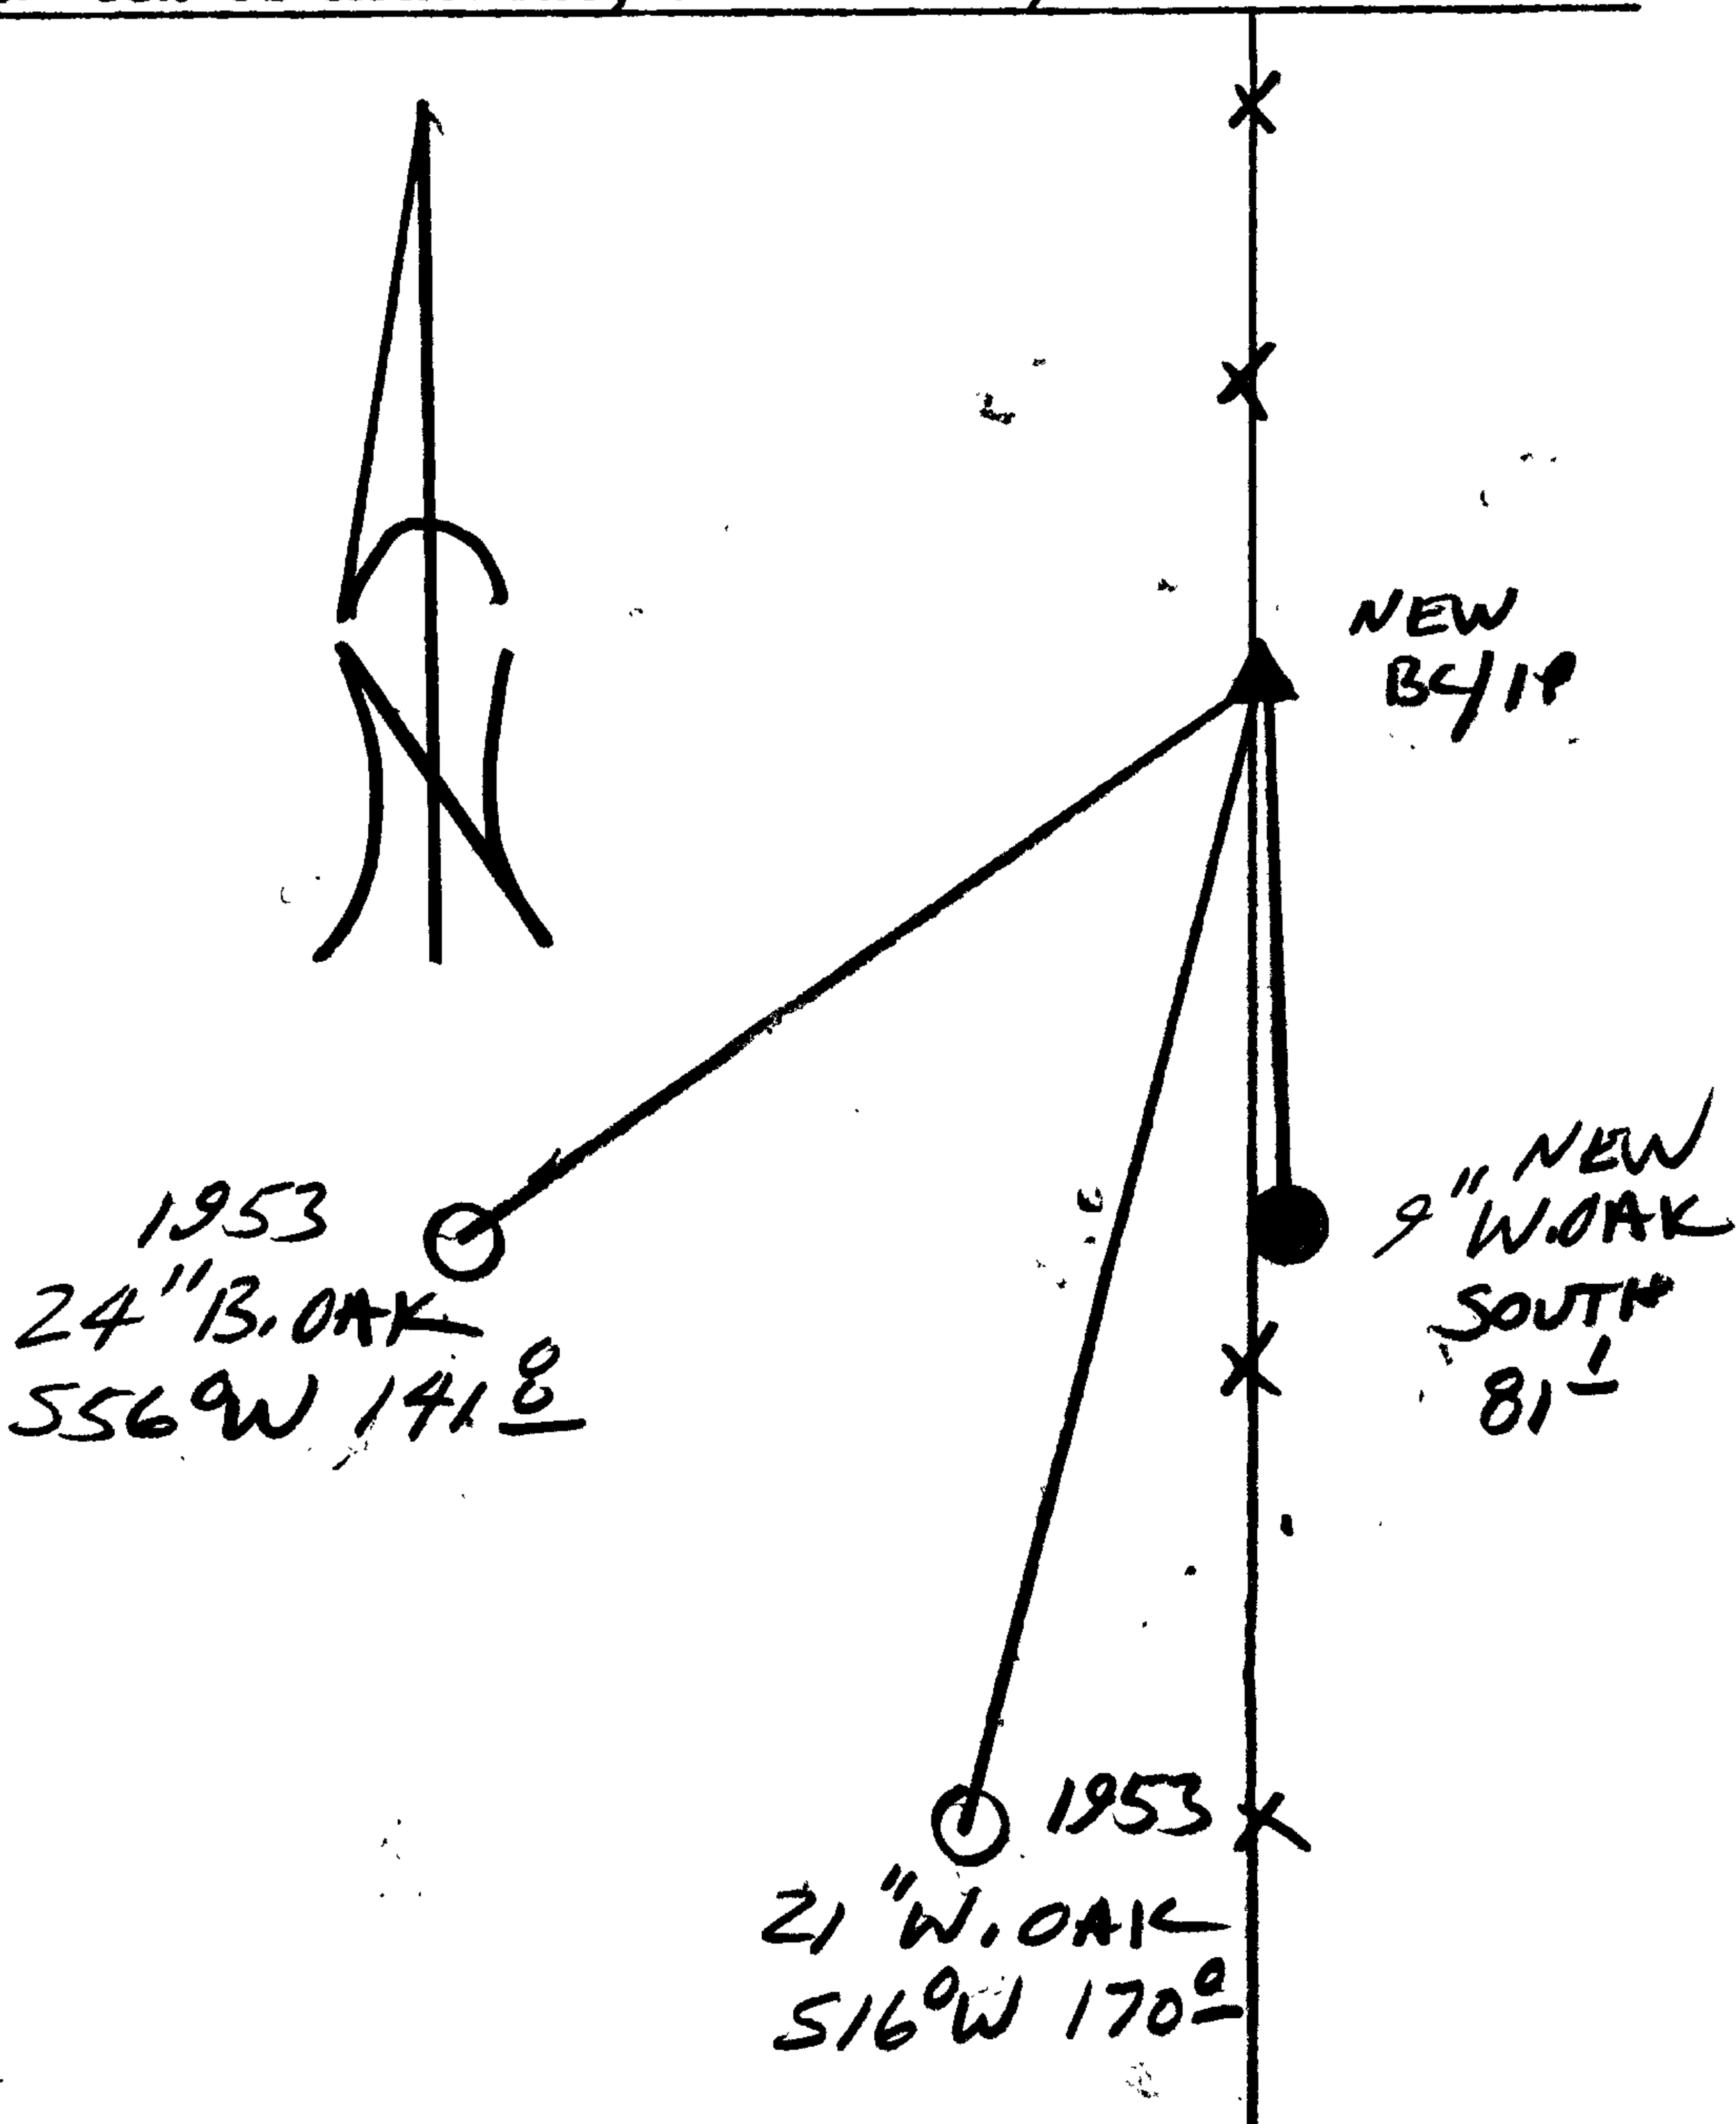

Location & Comments

OLD FENCE LINE KNOCKED OUT FIGHTING FIRE IN PAST, PER PROPERTY OWNER FENCE MAY NOT BE ON LINE NEWLY SET BC/1P LIES 9 FT EAST OF A N-S FENCE LINE

Comp. Declin. 17 3/4° E
Agency DC50
Party Chief RANDALL W. SMITH
Notekeeper *Randall W. Smith*
Witnesses STEPHEN J. FLASK

Address

Surveyor's Seal

REGISTERED PROFESSIONAL LAND SURVEYOR

Randall W. Smith
EXPIRES 6-30-2000

OREGON
JULY 25, 1990
RANDALL W. SMITH
2469