

GOVERNMENT CORNER RESTORATION FORM

Date: 5/24/1999 By: JC

This survey consists of:

Township 27S Range 7W Sec. 20 County DOUGLAS Map: \_\_\_\_\_  
State OR Date 2-8-1999 No. 052020.012 Narrative: \_\_\_\_\_  
Corner Plot: 66/8-28

Corner Designation

DLC  
52

DOUGLAS COUNTY  
SURVEYOR  
Condition Report Only  
 Not Found  
 Renewed  
 Unrecorded  
 Surveyed In  
 Referenced Out

Previous Renewals 1929 + 1966

Monument(s) Found:	(Condition and Source)
<u>STONE FOUND TOP MEASURES</u>	
<u>11" BY 6" PROTRUDS 6"</u>	
<u>ABOVE GROUND. 1929</u>	
<u>1/4" I.P. FROM 1929</u>	<u>NOT FOUND</u>
<u>NOTE: STONE FINELY</u>	
<u>SET AND PLUMB.</u>	

N/A

Accessories Found:

BEG'S AND DIST TAKEN FROM STONE

15" NOW ROTTEN OAK FOUND AT RECORD

" 568°E, 74.6 FT " OBT

16" NOW ROTTEN 17" DIA 2 FT HIGH D.FIR

STUMP SCRIBING FOUND "151", BEARS S50°E,

116.8 FT (AGREES WITH REC.) 1929.

9" NOW 22" DIA. D.FIR WITH A FULLY HEALED

SINGLE BLAZE, BEARS S45°E 26.7 FT

(REC. S39°E, 26.7 FT) 1966 / SEE SKETCH - DIST IS 26.7 ±

12" NOW 29" DIA. D.FIR WITH A FULLY HEALED

SINGLE BLAZE, BEARS N67°30'E, 12.5 FT

(REC. N83°E, 12.5 FT) 1966

\* Added 3/12/2024 JC

RENEWAL

Monument Detail

Monument Set (Procedure and Description)

5/8" DIA BY 30" LONG IRON  
 ROD WITH ALUM. CAP IS  
 SET ALONG EASTERN EDGE OF  
 STONE. I.R. BEARS EAST  
 0.5 FT FROM FOUND STONE,  
 PROTRUDS 5" ABOVE GROUND


DOUGLAS CO SURVEYOR  
 NW  
 52  
 1999

New Accessories BRG + DIST TAKEN TO STONE

9" W. OAK DOUBLE BLAZED AND SCRIBED "NW D.C. 52 CS. BT"  
 BEARS S55 1/2° W, 53.0 FT

17" D. FIR DOUBLE BLAZED AND SCRIBED "NW D.C. 52 CS. BT"  
 BEARS N62° W, 50.0 FT

Sketch of Monument, Accessories, and General Area

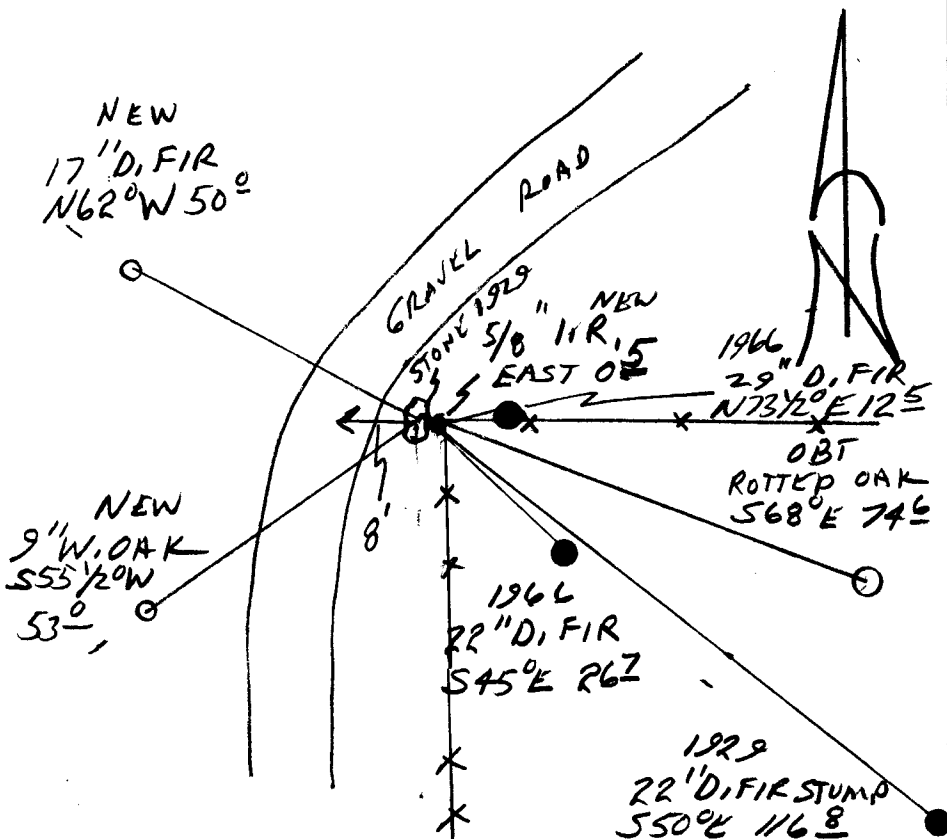

Location & Comments

CORNER LIES AT THE  
 INTERSECTION OF FENCE  
 LINES RUNNING EAST  
 AND SOUTH, 8 FT  
 EAST OF A PRIVATE  
 GRAVEL ROAD.

Comp. Declin. 17 3/4° E  
 Agency DCSO  
 Party Chief R. HALL W. SMITH  
 Notekeeper  
 Witnesses STEPHEN J. FLAISE

Address

Surveyor's Seal

REGISTERED  
 PROFESSIONAL  
 LAND SURVEYOR

*Randall W. Smith*  
 EXPIRES 6-30-2001

OREGON  
 JULY 25, 1990  
 RANDALL W. SMITH  
 2489