

GOVERNMENT CORNER RESTORATION FORM

Date: 5/24/1999 By: JC

Township 27S Range 2W Sec. 19

County DOUGLAS

This survey consists of:

State OR

Date 2-9-1999

No. 200340.012

Narrative:

Corner Rpt: 66/8-29

Corner Designation

1/4 S19/S20

DOUGLAS COUNTY

Condition Report Only

Not Found

Renewed

Unrecorded

Surveyed In

Referenced Out

MONUMENT DETAIL

Previous Renewals 1968 M33-27

Monument(s) Found: (Condition and Source)

2 1/2" DIA BRASS CAP ON A  
1 1/2" O.D. IRON PROTRUSION  
10" ABOVE GROUND (1968)

T27S R7W

1/4 COR. 19/20

LS 544

Accessories Found:

4" NOW 9" DIA MADRONE WITH A FULLY  
HEADED SINGLE BLAZE BEARS N6190W,  
216 FT CAGRES WITH REC.) 1968

16" NOW 35" DIA F. CHDAR WITH A FULLY  
HEADED SINGLE BLAZE BEARS S86 1/2 W/OE,  
140.7 FT CAGRES WITH REC.) 1968

RENEWAL

Monument Set (Procedure and Description)

Monument Detail

NONE


N/A

New Accessories

6" CEDAR DOUBLE BLAZED AND SCRIBED "1/4 S12CS RT"  
BEARS S 63 1/2° W, 5.2 FT

1 1/4" MADRONE BARK SCRIBED "1/4 S20CS BT"  
BEAR S 56° E, 12.0 FT

Sketch of Monument, Accessories, and General Area

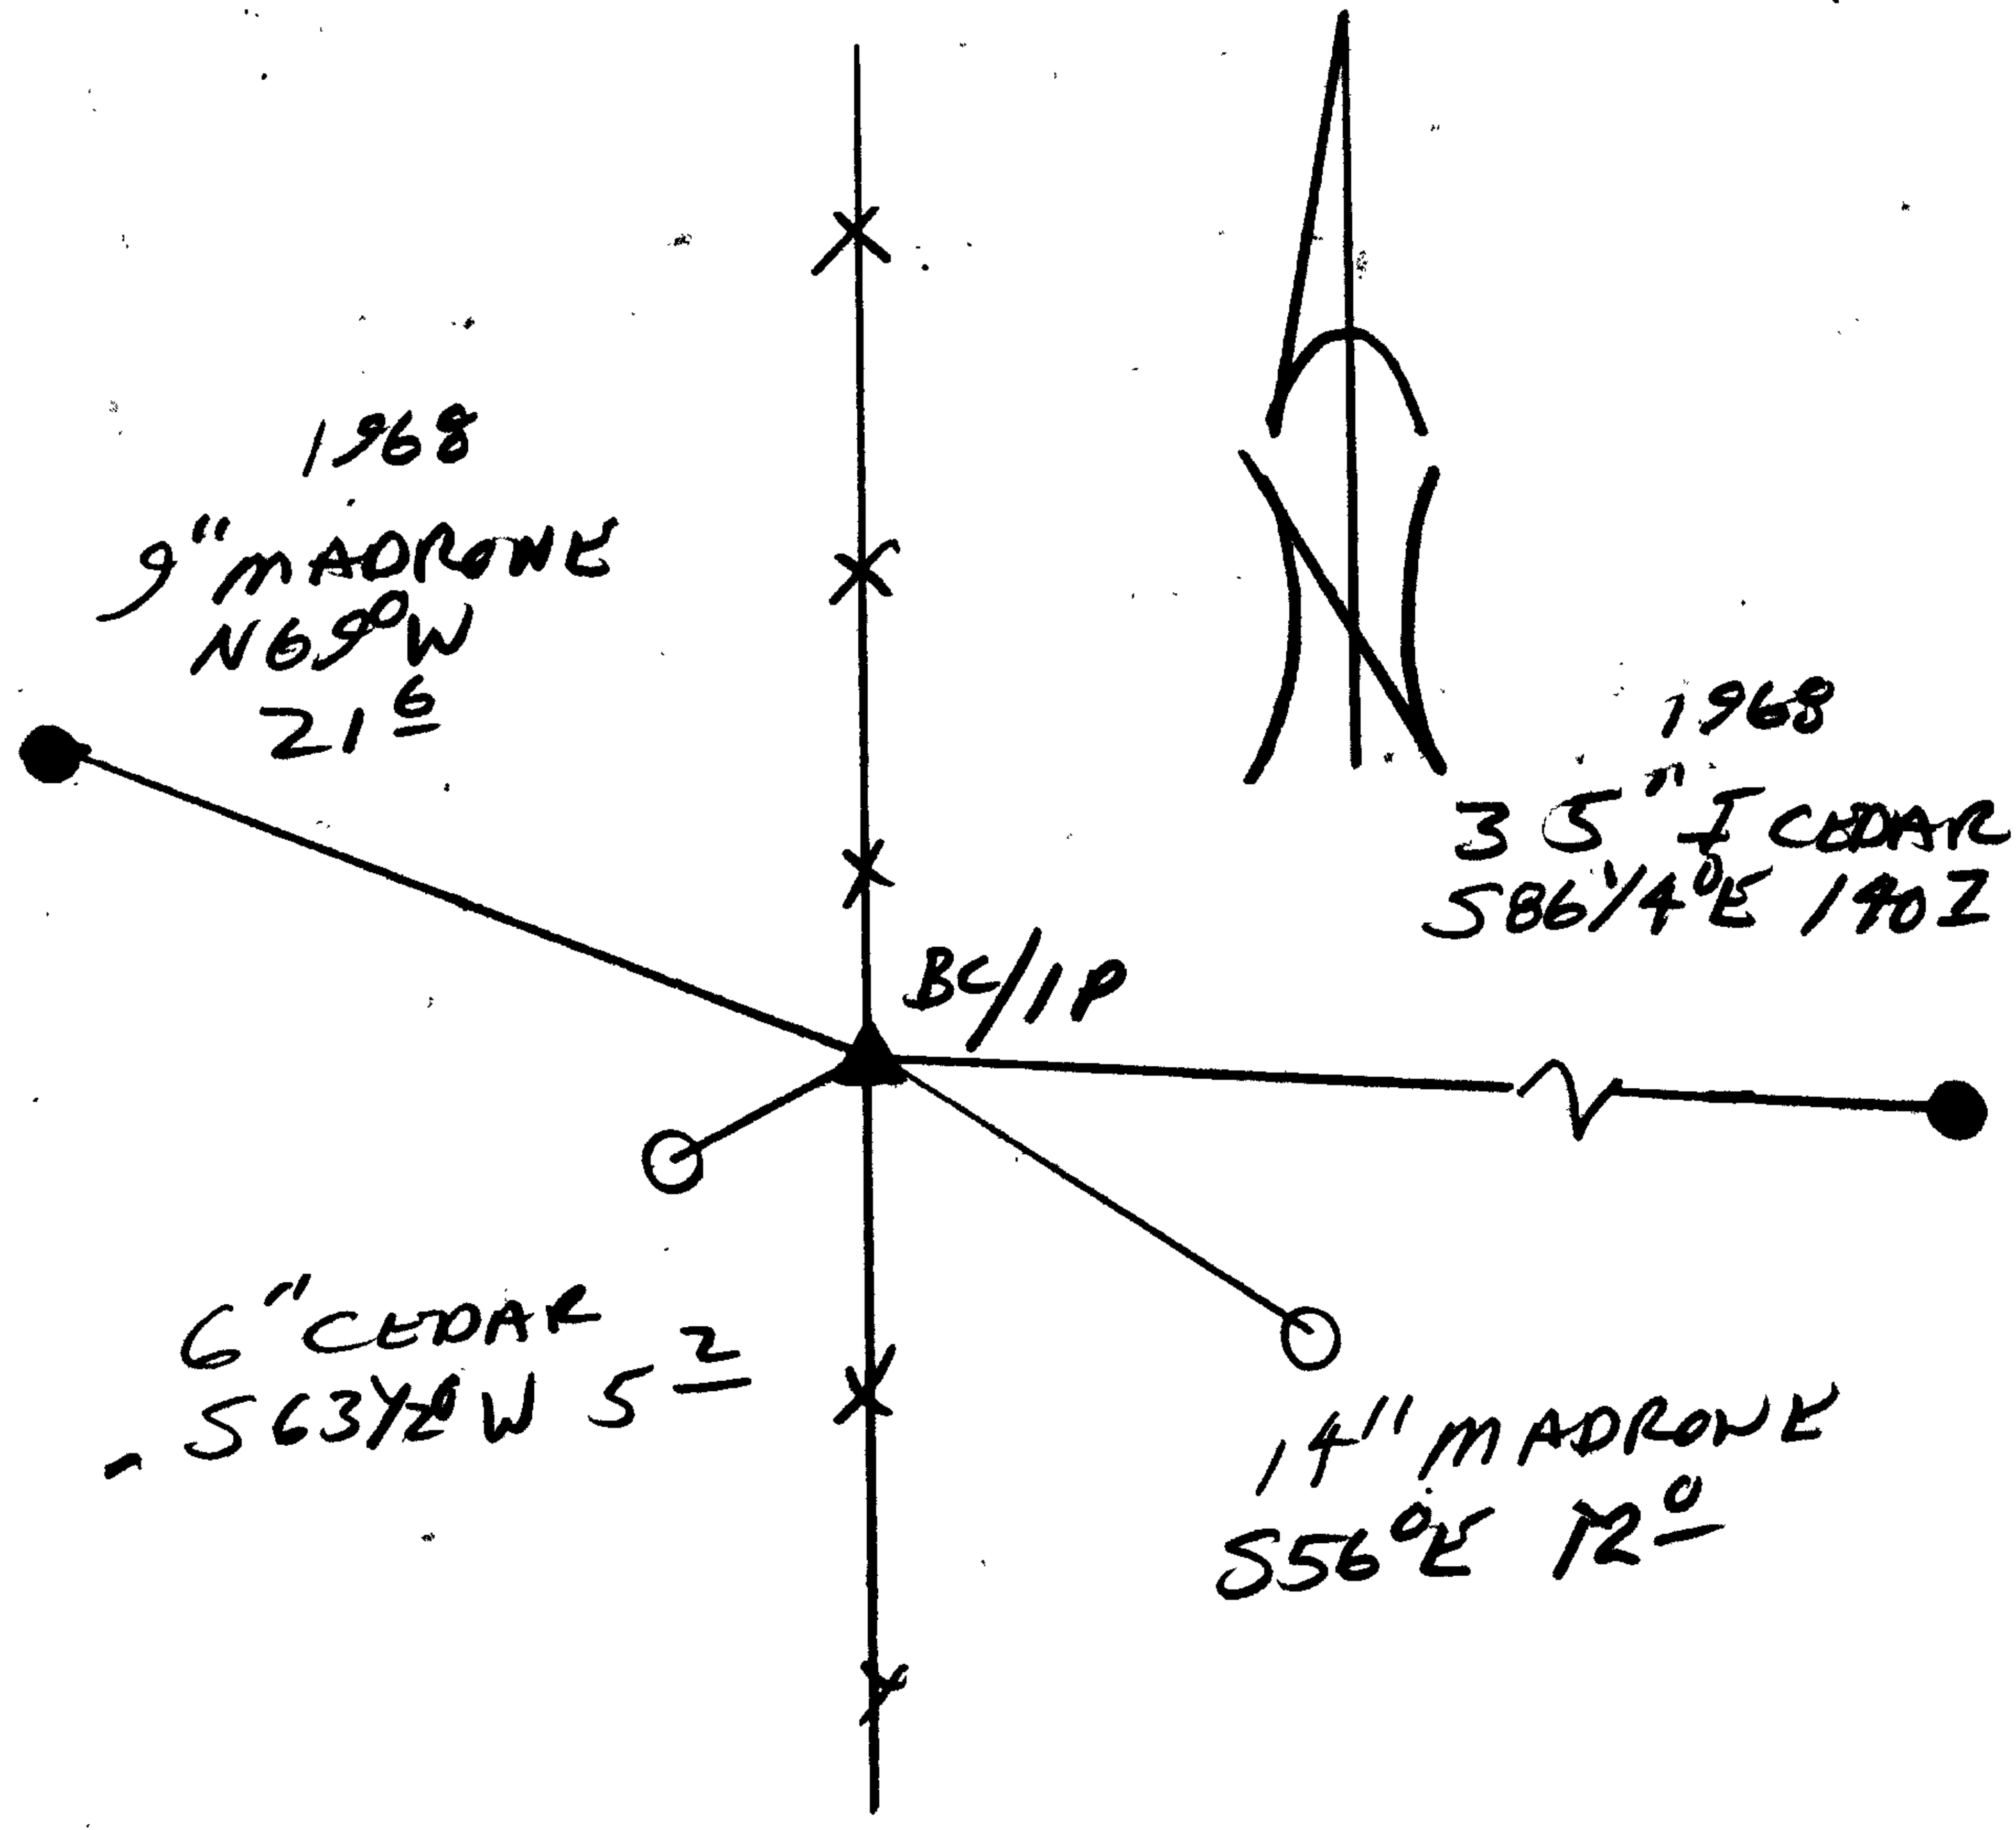

Location & Comments

CORNER LIES IN A  
N-S FENCE LINE

Comp. Declin. 17 3/4° E  
 Agency DCSO  
 Party Chief RANDALL W. SMITH  
 Notekeeper [Signature]  
 Witnesses STEPHEN J. HANSEN

Address

Surveyor's Seal

REGISTERED  
 PROFESSIONAL  
 LAND SURVEYOR

EXPIRES 6-30-2001  
[Signature]

OREGON  
 JULY 25, 1990  
 RANDALL W. SMITH  
 2469