

GOVERNMENT CORNER RESTORATION FORM

Date: 5-24-1999 By: JC
This survey consists of:

Township 25S Range 5W Sec. 19 County DOUGLAS Map: _____
State OR Date 3-31-99 No. 700300000 Narrative: _____
Corner Pt: 66/8-35

Corner Designation

S24	S19
S25 | S30

DOUGLAS COUNTY
SURVEYOR

- Condition Report Only
- Not Found
- Renewed
- Unrecorded
- Surveyed In
- Referenced Out

MONUMENT DETAIL

Previous Renewals 1972 OCSO, 1993 HULL

Monument(s) Found: (Condition and Source)

NOT FOUND

Accessories Found:

BRG'S + DIST. TAKE FROM NEW CORNER POSITION

24" NOW 31" DIA. CEDAR WITH A FULLY HEALED DOUBLE BLAZE, BEARS S32 1/2° W, 56.6 FT 1972

11" NOW 21" DIA. D. FIR WITH A FULLY HEALED DOUBLE BLAZE, BEARS N47 1/4° E, 24.0 FT 1972 (BLAZE FACES WEST)

9" NOW 16" DIA. D. FIR WITH A FULLY HEALED DOUBLE BLAZE, BEARS N19 3/4° W, 41.5 FT 1972

N/A

RENEWAL

Monument Set (Procedure and Description)

2 3/8" DIA. BRASS CAP ON A 1 3/8" O.D. BY 32" LONG IRON PIPE IS SET AT NEW PROPORTIONED CORNER POSITION, PROTRUDES 6" ABOVE GROUND.

Monument Detail

DOUGLAS COUNTY SURVEYORS T255


R 524 | 519 R
6 525 | 530 S
W W

1999 OFFICE

New Accessories

5" CEDAR DOUBLE BAZZED AND SCRIBED "X CS BT" BEARS S72°E, 16.1 FT

Sketch of Monument, Accessories, and General Area

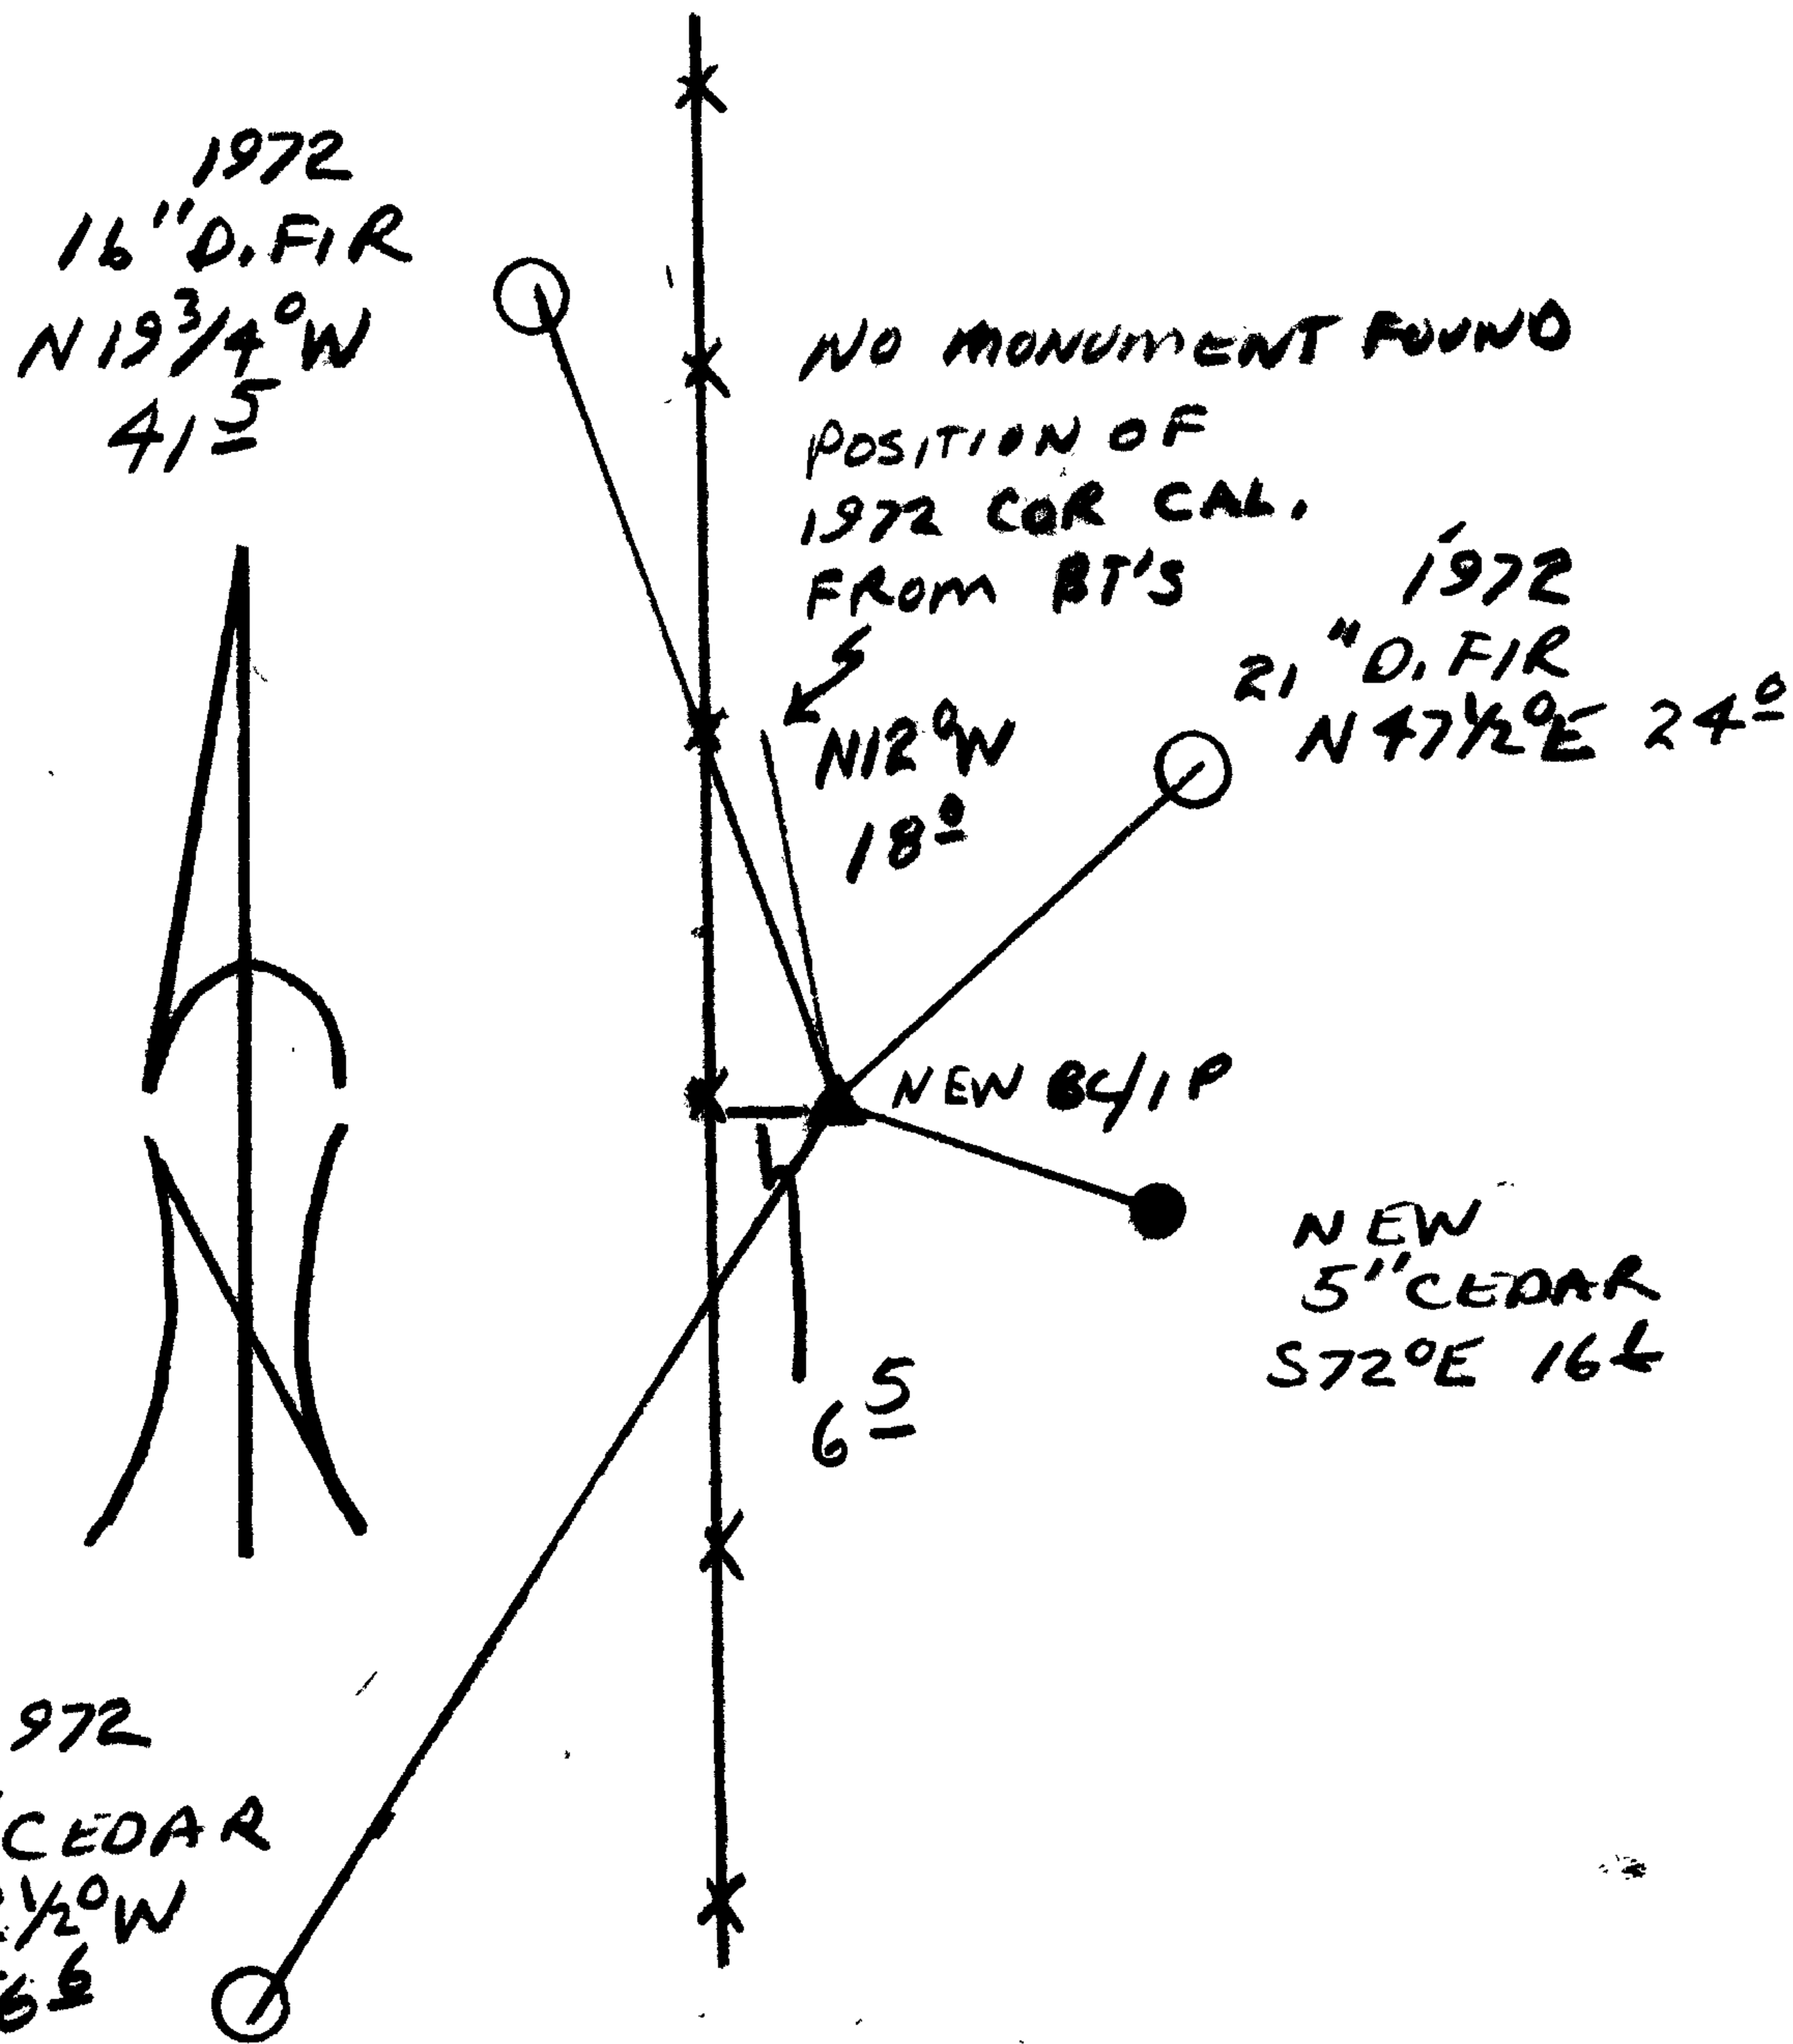

Location & Comments

CORNER LIES 6 1/2 FT EAST OF A N-S FENCE LINE

Comp. Declin. 17 3/4° E
Agency DCSO
Party Chief RANDALL W. SMITH
Notekeeper [Signature]
Witnesses STEPHEN J. FLAUSK

Address

Surveyor's Seal

REGISTERED PROFESSIONAL LAND SURVEYOR

[Signature] EXPIRES 6-30-2000

OREGON JULY 28, 1900 RANDALL W. SMITH 2400