

GOVERNMENT CORNER RESTORATION FORM

Date: 5/24/1999 By: XC

This survey consists of:

Township 26S Range 4W Sec. 7

County DOUGLAS Map: _____

State OR Date 4-28-99

No. 140500.003 Narrative: _____

Corner Rpt: 66/B-39

Corner Designation

$\frac{1}{4} \frac{S7}{S18}$

DOUGLAS COUNTY SURVEYOR

- ____ Condition Report Only
- ____ Not Found
- Renewed
- ____ Unrecorded
- ____ Surveyed In
- ____ Referenced Out

Previous Renewals 1929 + 1958 DCSO

Monument(s) Found: (Condition and Source)

2 1/2" DIA BRASS CAP ON A 1 1/2" O.D. IRON PIPE, PROTRUDES 7" ABOVE GROUND. 1958

COUNTY SURVEYORS OFFICE

$\frac{1}{4} \frac{S7}{S18}$

T26S R4W
1958

Accessories Found:

25" NOW 34" DIA. W. OAK WITH FULLY HEALED BLAZE, BEARS N71°W 31.0 FT (REC, N75°W, 31.0 FT) 1958

18" NOW DOWN AND ROTTED OAK, ROOT HOLE BEARS N75°E, 35.6 FT (AGREES WITH REC.) 1958

10" NOW 11" DIA. W. OAK WITH A NEARLY FULLY HEALED PREVIOUSLY OPENED BLAZE, BEARS N12°W, 30.6 FT (AGREES WITH 1958 REC.) 1929

10" NOW 15" DIA. W. OAK WITH A FULLY HEALED BLAZE, BEARS S60 1/2°E, 23.8 FT (AGREES WITH 1958 REC.) 1929

RENEWAL

Monument Set (Procedure and Description)

NONE


Monument Detail

N/A

New Accessories

11" DIA. D. FIR DOUBLE BLAZED AND SCRIBED "4518 CS 17"; BEARS 561°W, 39.4 FT

Sketch of Monument, Accessories, and General Area

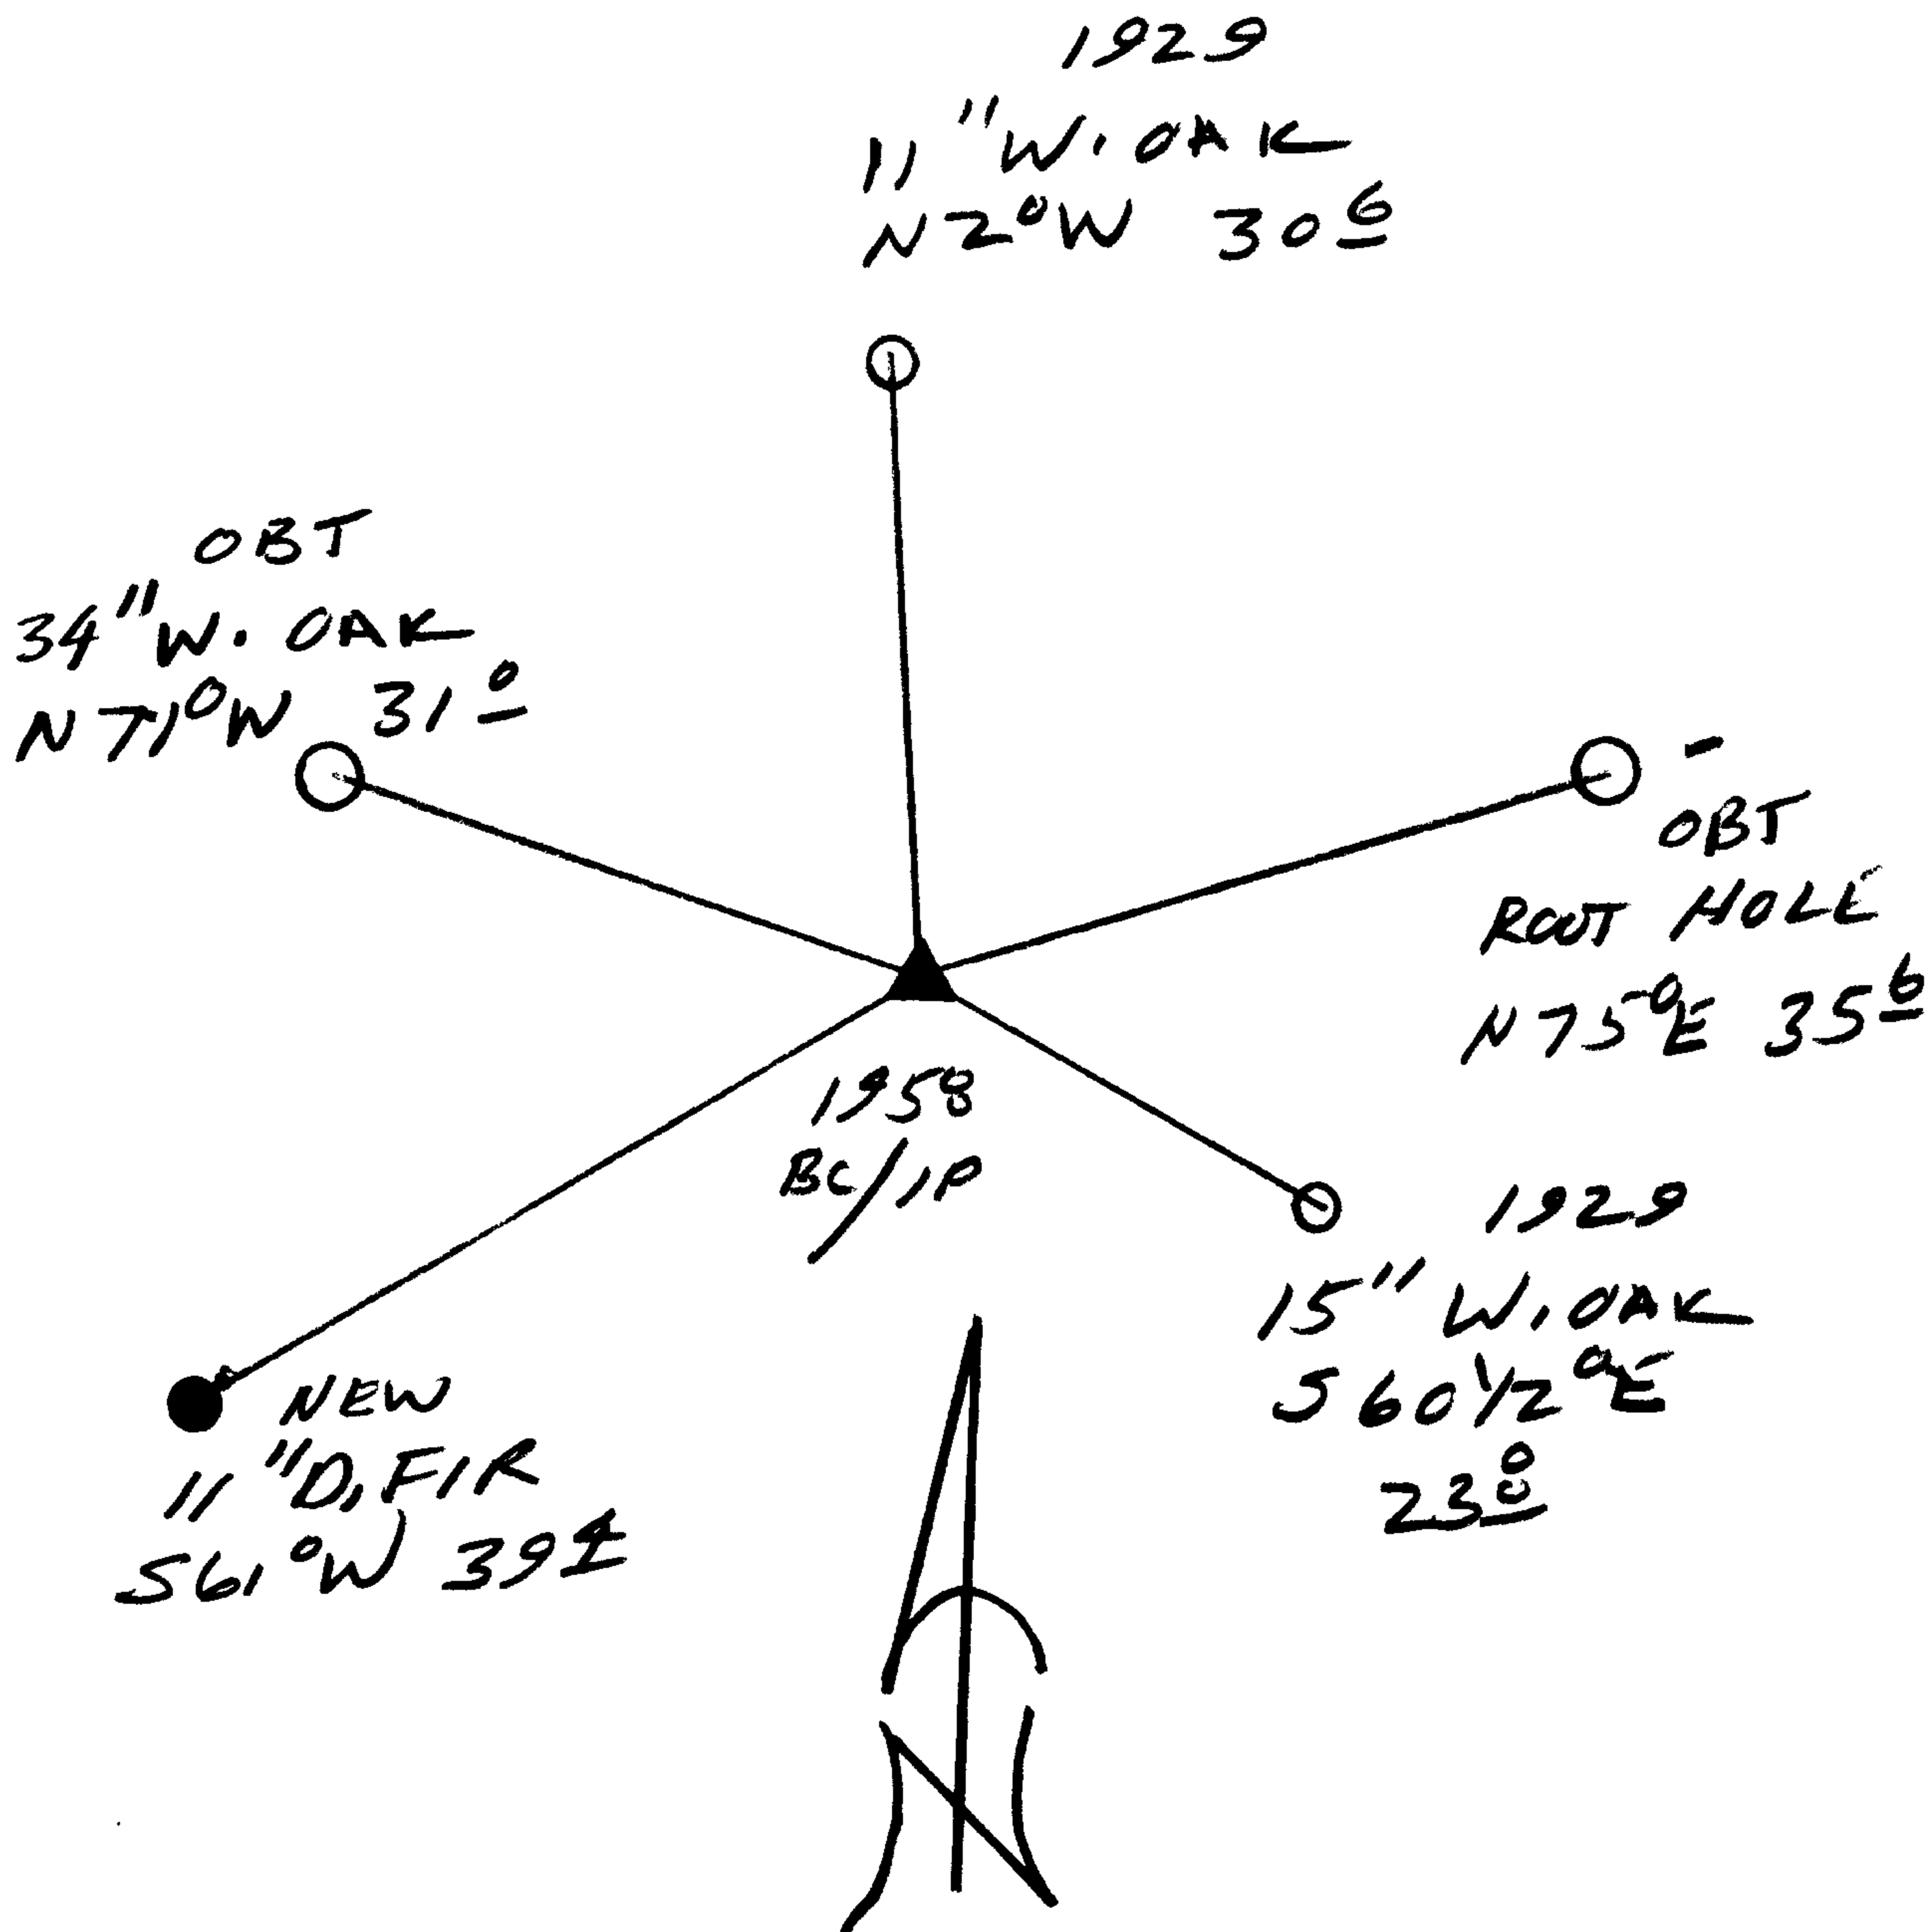

Location & Comments

Comp. Declin. 17 3/4° E
 Agency DCSO
 Party Chief RANDALL W. SMITH
 Notekeeper [Signature]
 Witnesses STEPHEN J. FLAVER

Address

Surveyor's Seal

REGISTERED
 PROFESSIONAL
 LAND SURVEYOR

[Signature]
 07/25/2000

OREGON
 JULY 25, 1990
 RANDALL W. SMITH
 2469