

GOVERNMENT CORNER RESTORATION FORM

Date: 6-23-1999 By: JC

Township 26S Range 4W Sec. 18

County DOUGLAS This survey consists of: Map:

State OR Date 4-27-99

No. 148400-008 Narrative: Corner Ref: 66/8-40

Corner Designation

DOUGLAS COUNTY

Condition Report Only

Not Found

Renewed

Unrecorded

Surveyed In

Referenced Out

Previous Renewals 1960 DCSG

Monument(s) Found: (Condition and Source)

2 1/2" DIA BRASS CAP ON A 1 1/2"  
O.D. IRON PIPE, SURVIVING  
BY A MOUND OF STONE, PROTRUDES  
1/6" ABOVE GROUND.

COUNTY SURVEYORS OFFICE  
T26S R4W

S18  
S19  
M.C.  
1960

Accessories Found:

2" NOW 22" DIA. W. OAK WITH A PREVIOUSLY OPENED  
HEALED BLAZE, BEARS S19°W, 11.9 FT. E  
(AGREES WITH REC.) 08T

13" NOW 18" DIA. CEDAR WITH A FULLY HEALED  
DOUBLE BLAZE BEARS N82°E, 43.3 FT  
(AGREES WITH REC.) 1960

1960 SW BT NOW GONE

RENEWAL

Monument Set (Procedure and Description)

Monument Detail

NONE

N/A


New Accessories

1 1/2" DIA. PINK DOUBLE BLAZED AND SCRIBED "MCS 19 CS BT" BEARS S 24° E, 39.6 FT

6" CHISELED "+" IN LARGE ROCK OUTCROP 15 FT NORTH OF SOUTH END AND 4 FT ABOVE GROUND, ON EASTERN SIDE OF OUTCROP, BEARS S 45° W, 101.3 FT

Sketch of Monument, Accessories, and General Area

Location & Comments

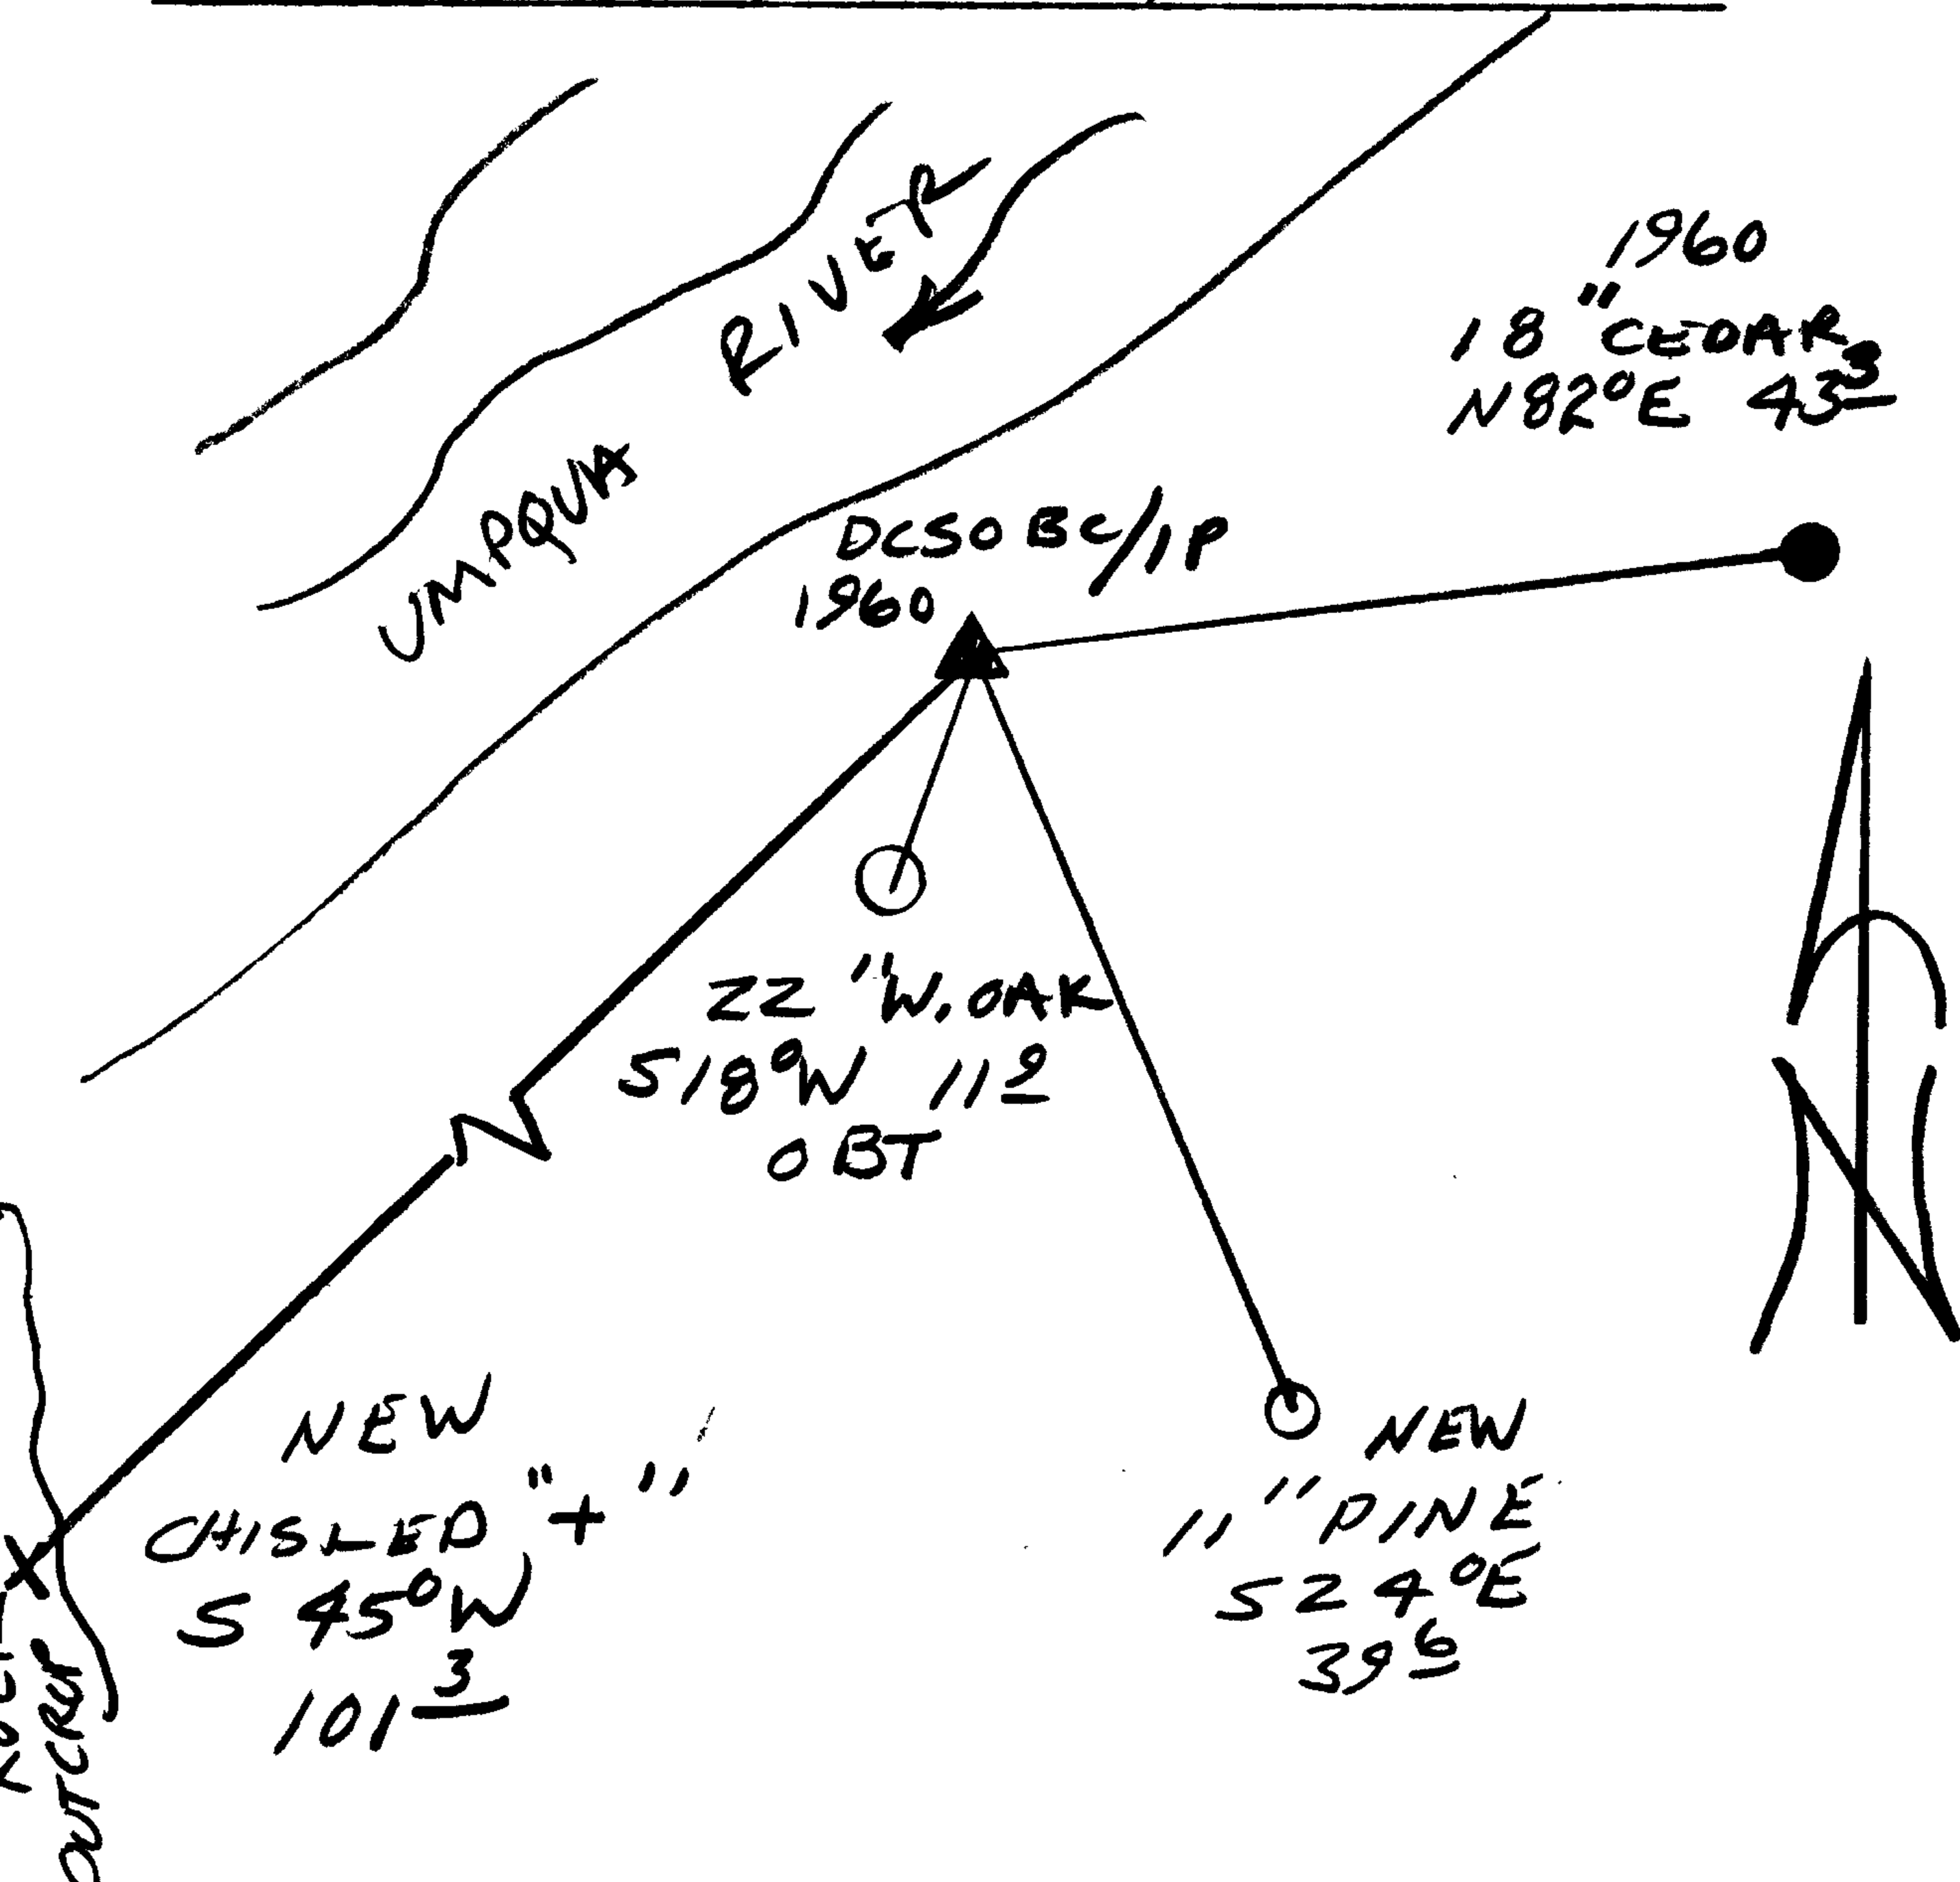

Location & Comments

\_\_\_\_\_

\_\_\_\_\_

Comp. Declin. 17 3/4 ° E

Agency DCS O

Party Chief RANDALL W SMITH

Notekeeper Charles W. Smith

Witnesses STEPHEN J FLAUS

Address \_\_\_\_\_

Surveyor's Seal

REGISTERED PROFESSIONAL LAND SURVEYOR

*Randall W. Smith*

EXPIRES 6-30-2000

OREGON

JULY 25, 1990

RANDALL W. SMITH

2469