

GOVERNMENT CORNER RESTORATION FORM

Date: 7-12-1999 By: JC

This survey consists of:

Township 26 S Range 4 W Sec. 19 County DOUGLAS

Map: _____

State OR Date 6-21-1999 No. 100240.008

Narrative: _____

Corner Rpt: 66 | 8-43

Corner Designation

1/4 S24 | S19

DOUGLAS COUNTY SURVEYOR

- Condition Report Only
- Not Found
- Renewed
- Unrecorded
- Surveyed In
- Referred Out

MONUMENT DETAIL

Previous Renewals VOL 5 pg 2, 1958 DCSO, VOL 13 pg 23

Monument(s) Found: (Condition and Source)

1" O.D. IRON PIPE, FOUND
1" BELOW GROUND, VOL 5 pg 2
1919

N/A

Accessories Found:

2 1/2" BRASS CAP ON A 1 1/2" O.D. IRON PIPE, PROTRUDES
10" ABOVE GROUND, BEARS N 29° E, 17.4 FT. (AGREES
WITH REC.) 1958

5/8" I.R. FOUND 1/2 FT BELOW RIVER BANK SAND,
BEARS "N 77 1/2° E 180.5 FT" RECORD PER
VOL 13 pg 23 1968

10" W. OAK BLAZED AND SCRIBED FOR W.C. MC,
IN 1958, AGREES WITH CALCULATED RECORD
" S 38° W, 36.0 FT" 1958

9" W. OAK BLAZED AND SCRIBED FOR W.C. MC IN 1958,
AGREES WITH CALCULATED RECORD " N 46° E, 32.2 FT, 1958

1 1/8" W. OAK PREVIOUSLY OPENED IN TWO PLACES, BOTH
ROTTED NO SCRIBING/VISIBLE, BLAZES FACE "NW" LY
AGREES WITH CALCULATED RECORD " N 53 1/2° E, 189.1 1/2 FT"
OBT FOR MC 1951

RENEWAL

Monument Set (Procedure and Description)

NONE


Monument Detail

N/A

New Accessories

NONE

Sketch of Monument, Accessories, and General Area

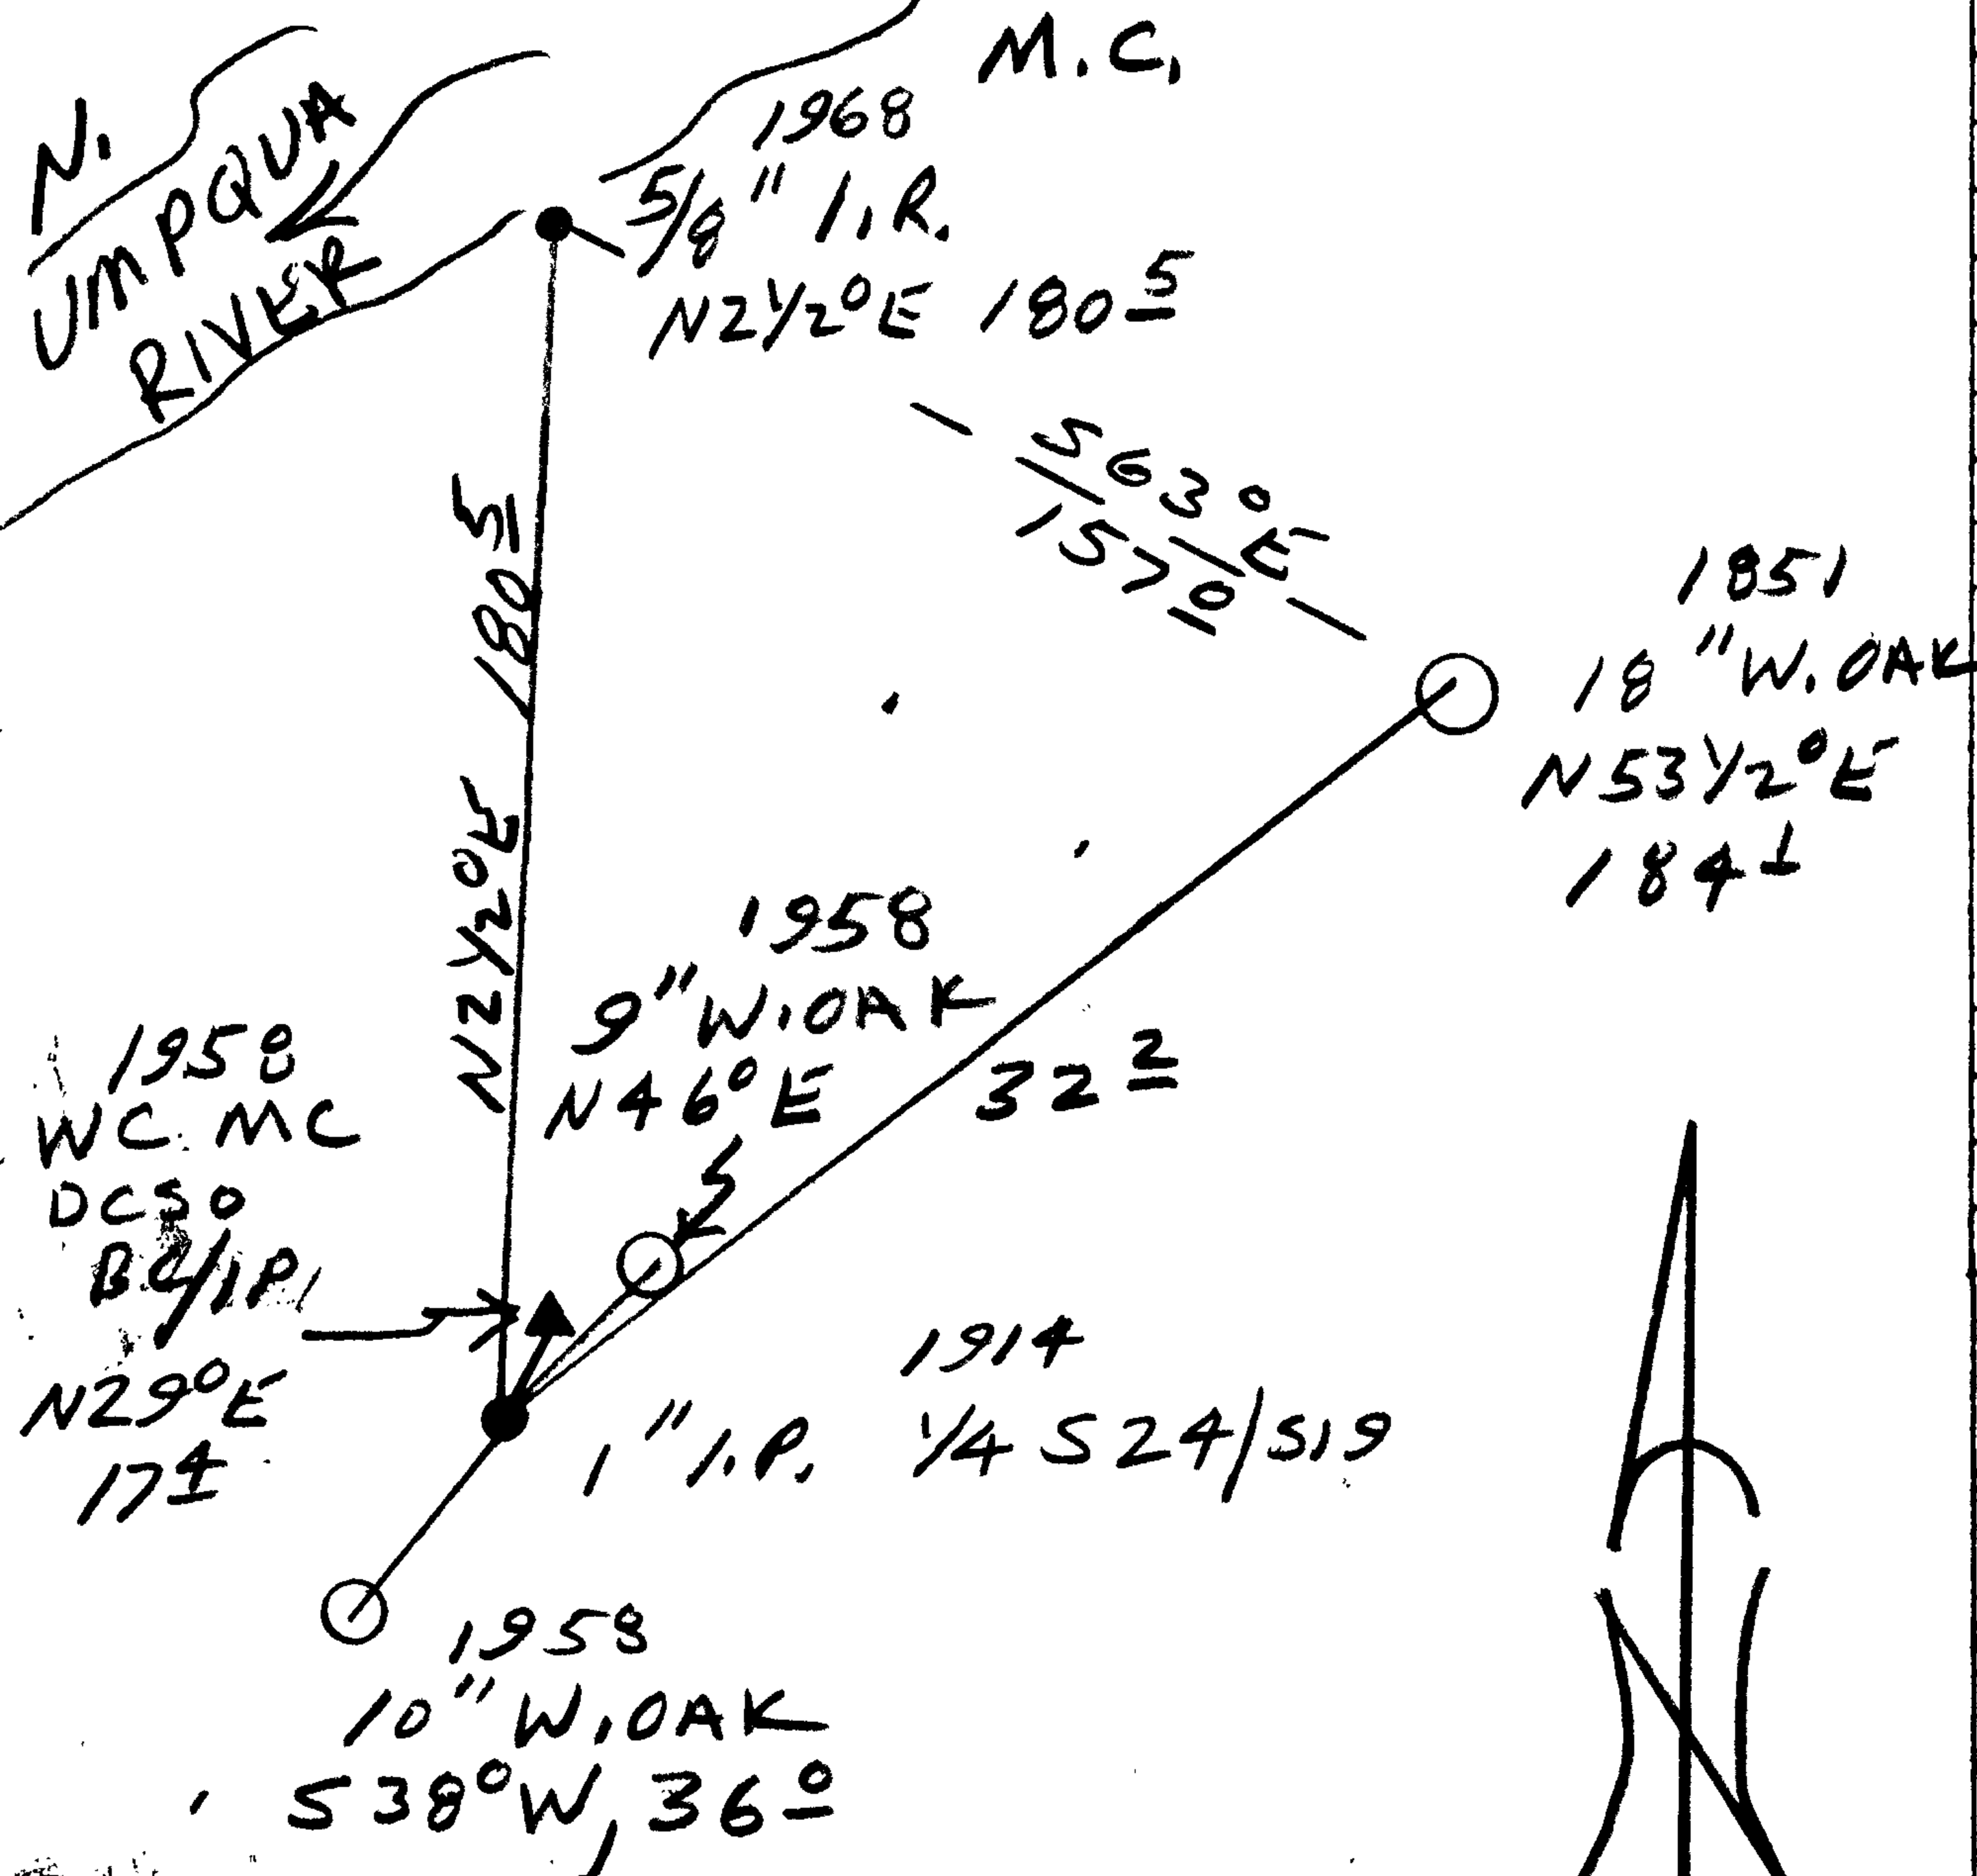

Location & Comments

Comp. Declin. 17 3/4° E
 Agency DCSO
 Party Chief RANDALL W. SMITH
 Notekeeper [Signature]
 Witnesses STEPHEN J. THORNTON

Address

Surveyor's Seal

REGISTERED
 PROFESSIONAL
 LAND SURVEYOR

Randall W. Smith
 EXPIRES 6-30-2000

OREGON
 JULY 25, 1990
 RANDALL W. SMITH
 2469