

FILED

Date: 10-14-1999 By: JC

GOVERNMENT CORNER RESTORATION FORM

This survey consists of:

Township 26S Range 3W Sec. 10

County DOUGLAS

Map: \_\_\_\_\_

State OR Date 9-27-99

No 500540.01

Narrative: \_\_\_\_\_

Corner Rpt: 66/12-3

Corner Designation

W.C.

DOUGLAS COUNTY SURVEYOR

1957

1/4 S10 | S11

TO COR SOUTH 14.1 FT

- Condition Report Only
- Not Found
- Renewed
- Unrecorded
- Surveyed In
- Referenced Out

Previous Renewals 1923, 1933, 1957, 1977 + 1984 DCSO

MONUMENT DETAIL

Monument(s) Found: (Condition and Source)

2 1/2" DIA BRASS CAP ON A  
 1 1/2" O.D IRON PIPE, 1 FT  
 BELOW GROUND, IN ROAD  
 SHOULDER. 1977 WITH  
 A 5/8" I.R. ALONG NORTH  
 EDGE, 1974

1974 BAUGHMAN

DOUGLAS COUNTY SURVEYORS

T26S R3W  
 N. TO  
 1/4 S10 | S11  
 16.0 FT.  
 1977

5/8" I.R. SET AT 1957 W.C  
 POSITION, FOUND 18" BELOW  
 GROUND IN ROAD SHOULDER  
 1977

Accessories Found:

1957 COR. POSITION

48" NOW 49" DIA. D.FIR SHOWING EVIDENCE OF BARK  
 SCRIBING REMOVAL BY DCSO IN 1977. RE REBARK  
 SCRIBE "WC 1/4 S10 CS BT" BEARS EAST, 62.8 FT  
 (AGREES WITH REC.) 1957

6" NOW 12" DIA W. OAK SHOWING EVIDENCE OF SCRIBING  
 BEING REMOVE BY DCSO IN 1977 AND A FULLY  
 HEADED DOUBLE BLAZE ON WEST TRUNK, WE  
 DOUBLE BLAZE EAST TRUNK AND SCRIBE "WC  
 1/4 S10 CS BT" NOTE UPPER BLAZE 6 FT  
 ABOVE GROUND, BEARS S15°W, 73.2 FT,  
 (AGREES WITH REC.) 1957

1974 BT'S TO BAUGHMAN CORNER  
 SE BT 75 12" DIA. W. OAK 1974

SW BT NOW DOWN AND OUT OF POSITION 1974

1/2" I.R. PER 1977 IS PRESENT

RENEWAL

Monument Detail

Monument Set (Procedure and Description)

REMOVED MARKS FROM 1977  
BRASS CAP.


A 5/8" BY 5 FT LONG IRON  
ROD IS DRIVEN INTO GROUND  
ALONG SOUTH EDGE OF FOUNDED  
1977 I.R. PROTRUSING 1 FT  
ABOVE ROAD SHOULDER  
DCSO YELLOW PLASTIC  
CAP PLACED ON TOP.

N/A

New Accessories

UNMARKED BRASS CAP AS NOTED ABOVE PER REC. BEARS 572°W  
84.0 FT

Sketch of Monument, Accessories, and General Area

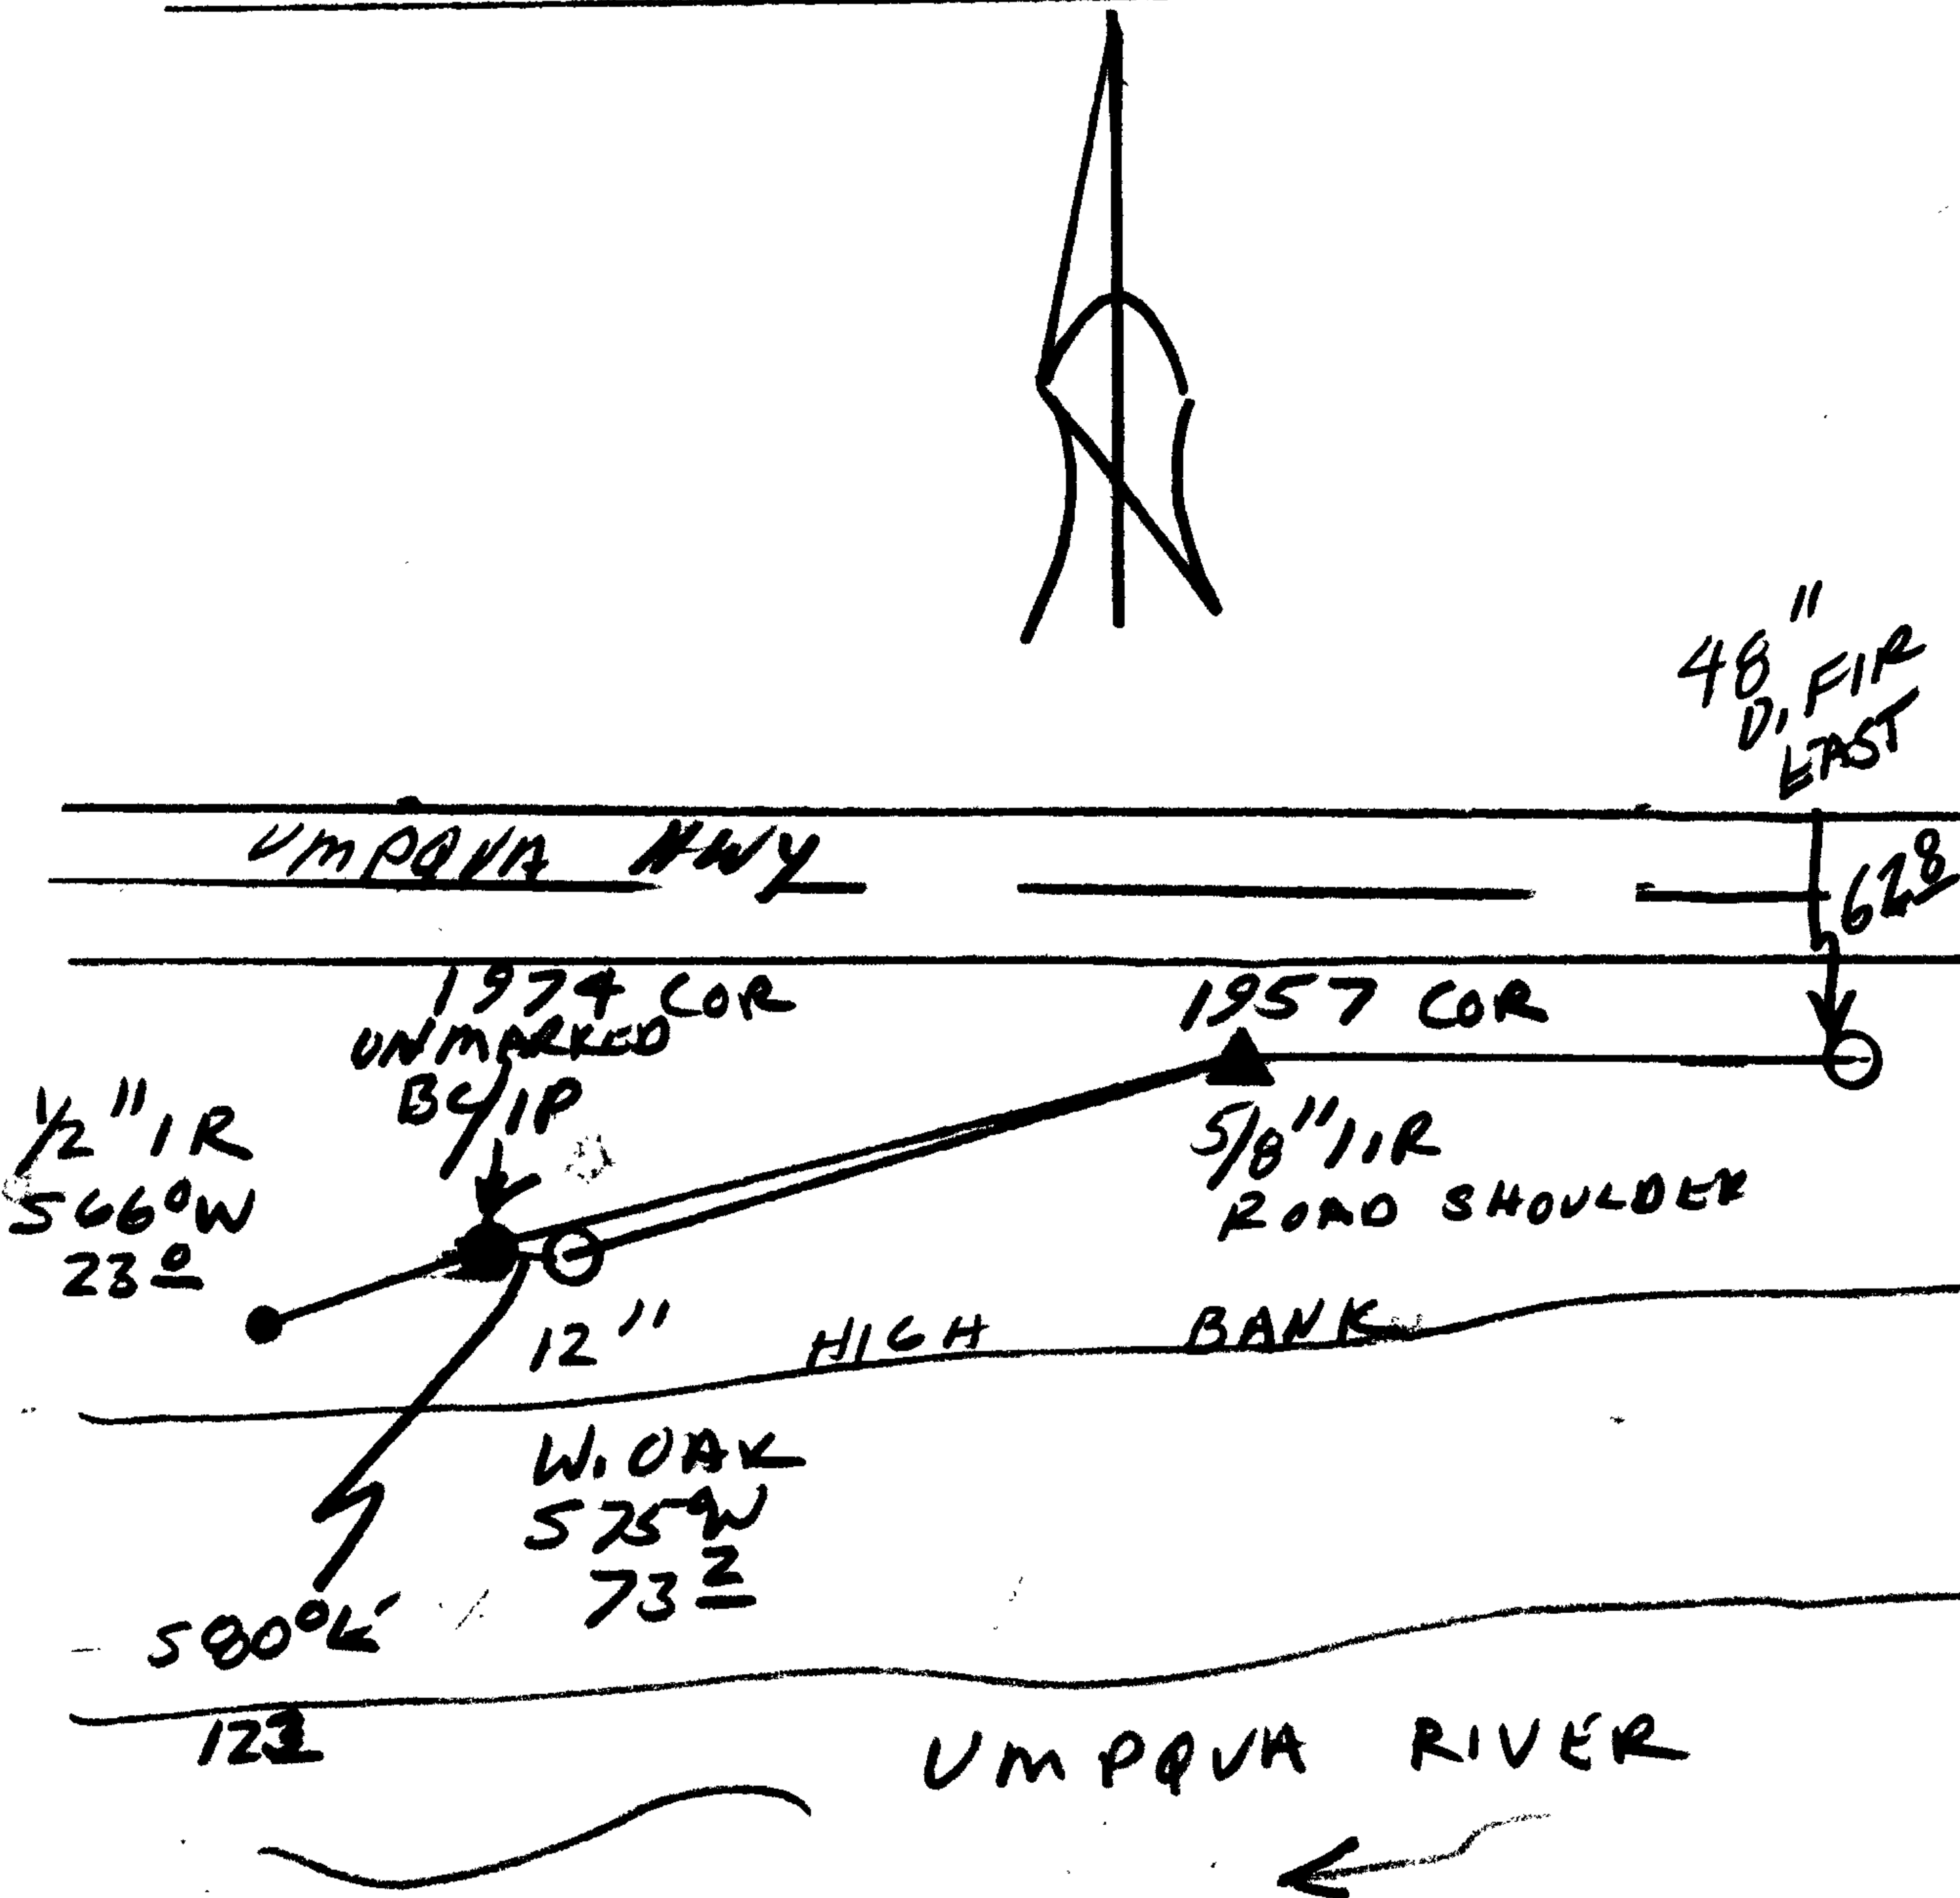

Location & Comments

SEE BLM CORRESPONDENCE  
IN CS 59/21 ON  
ACCEPTANCE OF CORNERS

Comp. Declin. 17 3/4° E  
Agency DCSO  
Party Chief RANDALL W. SMITH  
Notekeeper [Signature]  
Witnesses STEPHEN J. FLEMING

Address

Surveyor's Seal