

FILED

GOVERNMENT CORNER RESTORATION FORM

Date: 10-18-1999 By: JC

Township 30S Range 3W Sec. 30

County DOUGLAS

This survey consists of:

State OK

Date 2-24-99

No. _____

Map: _____

Narrative: _____

Corner Rpt: 66/12-5

Corner Designation

DLC
39

DOUGLAS COUNTY
SURVEYOR

Condition: Surveyor

Not Found

Renewed

Unrecorded

Surveyed In

Referenced Out

Previous Renewals 1930 DCSO

MONUMENT DETAIL

Monument(s) Found: (Condition and Source)

BOULDER FROM 1930
NOT FOUND CORNER LIES
IN CUT BANK OF NEW
ROAD CONSTRUCTION

N/A

Accessories Found:

12" NW 32" DIA D.FIR WITH BARK SCRIBING
" INT COR CL 39 CS", BEARS N60°E, 30.4 FT, 1930
1930 NW BT NWL ROOT HOLE FOUND AT
RECORD " N30°W, 17.2 FT"

C.S. File No. 66/12-5

RENEWAL

Monument Set (Procedure and Description)

5/8" X 30" LONG IRON ROD WITH DCSO ALUM CAP STAMPED "INT DLC 39". IS SET AT POSITION DETERMINED FROM 1930 RT. PROTRUDES 3" ABOVE GROUND.


Monument Detail

N/A

New Accessories

23" DIA. D. FIR SINGLE BLAZED AND SCRIBED "INT DLC 39 CS BT" BEARS N28°W, 26.5 FT
4" DIA. MADRONE BARK SCRIBED "X CS BT" BEARS N7°E, 24.5 FT
5/8" I.R. WITH YELLOW PLASTIC CAP MARKED "AA" BEARS N50°W, 60.1 FT. (CS 660 + 99.73 70) R/W PIN

Sketch of Monument, Accessories, and General Area

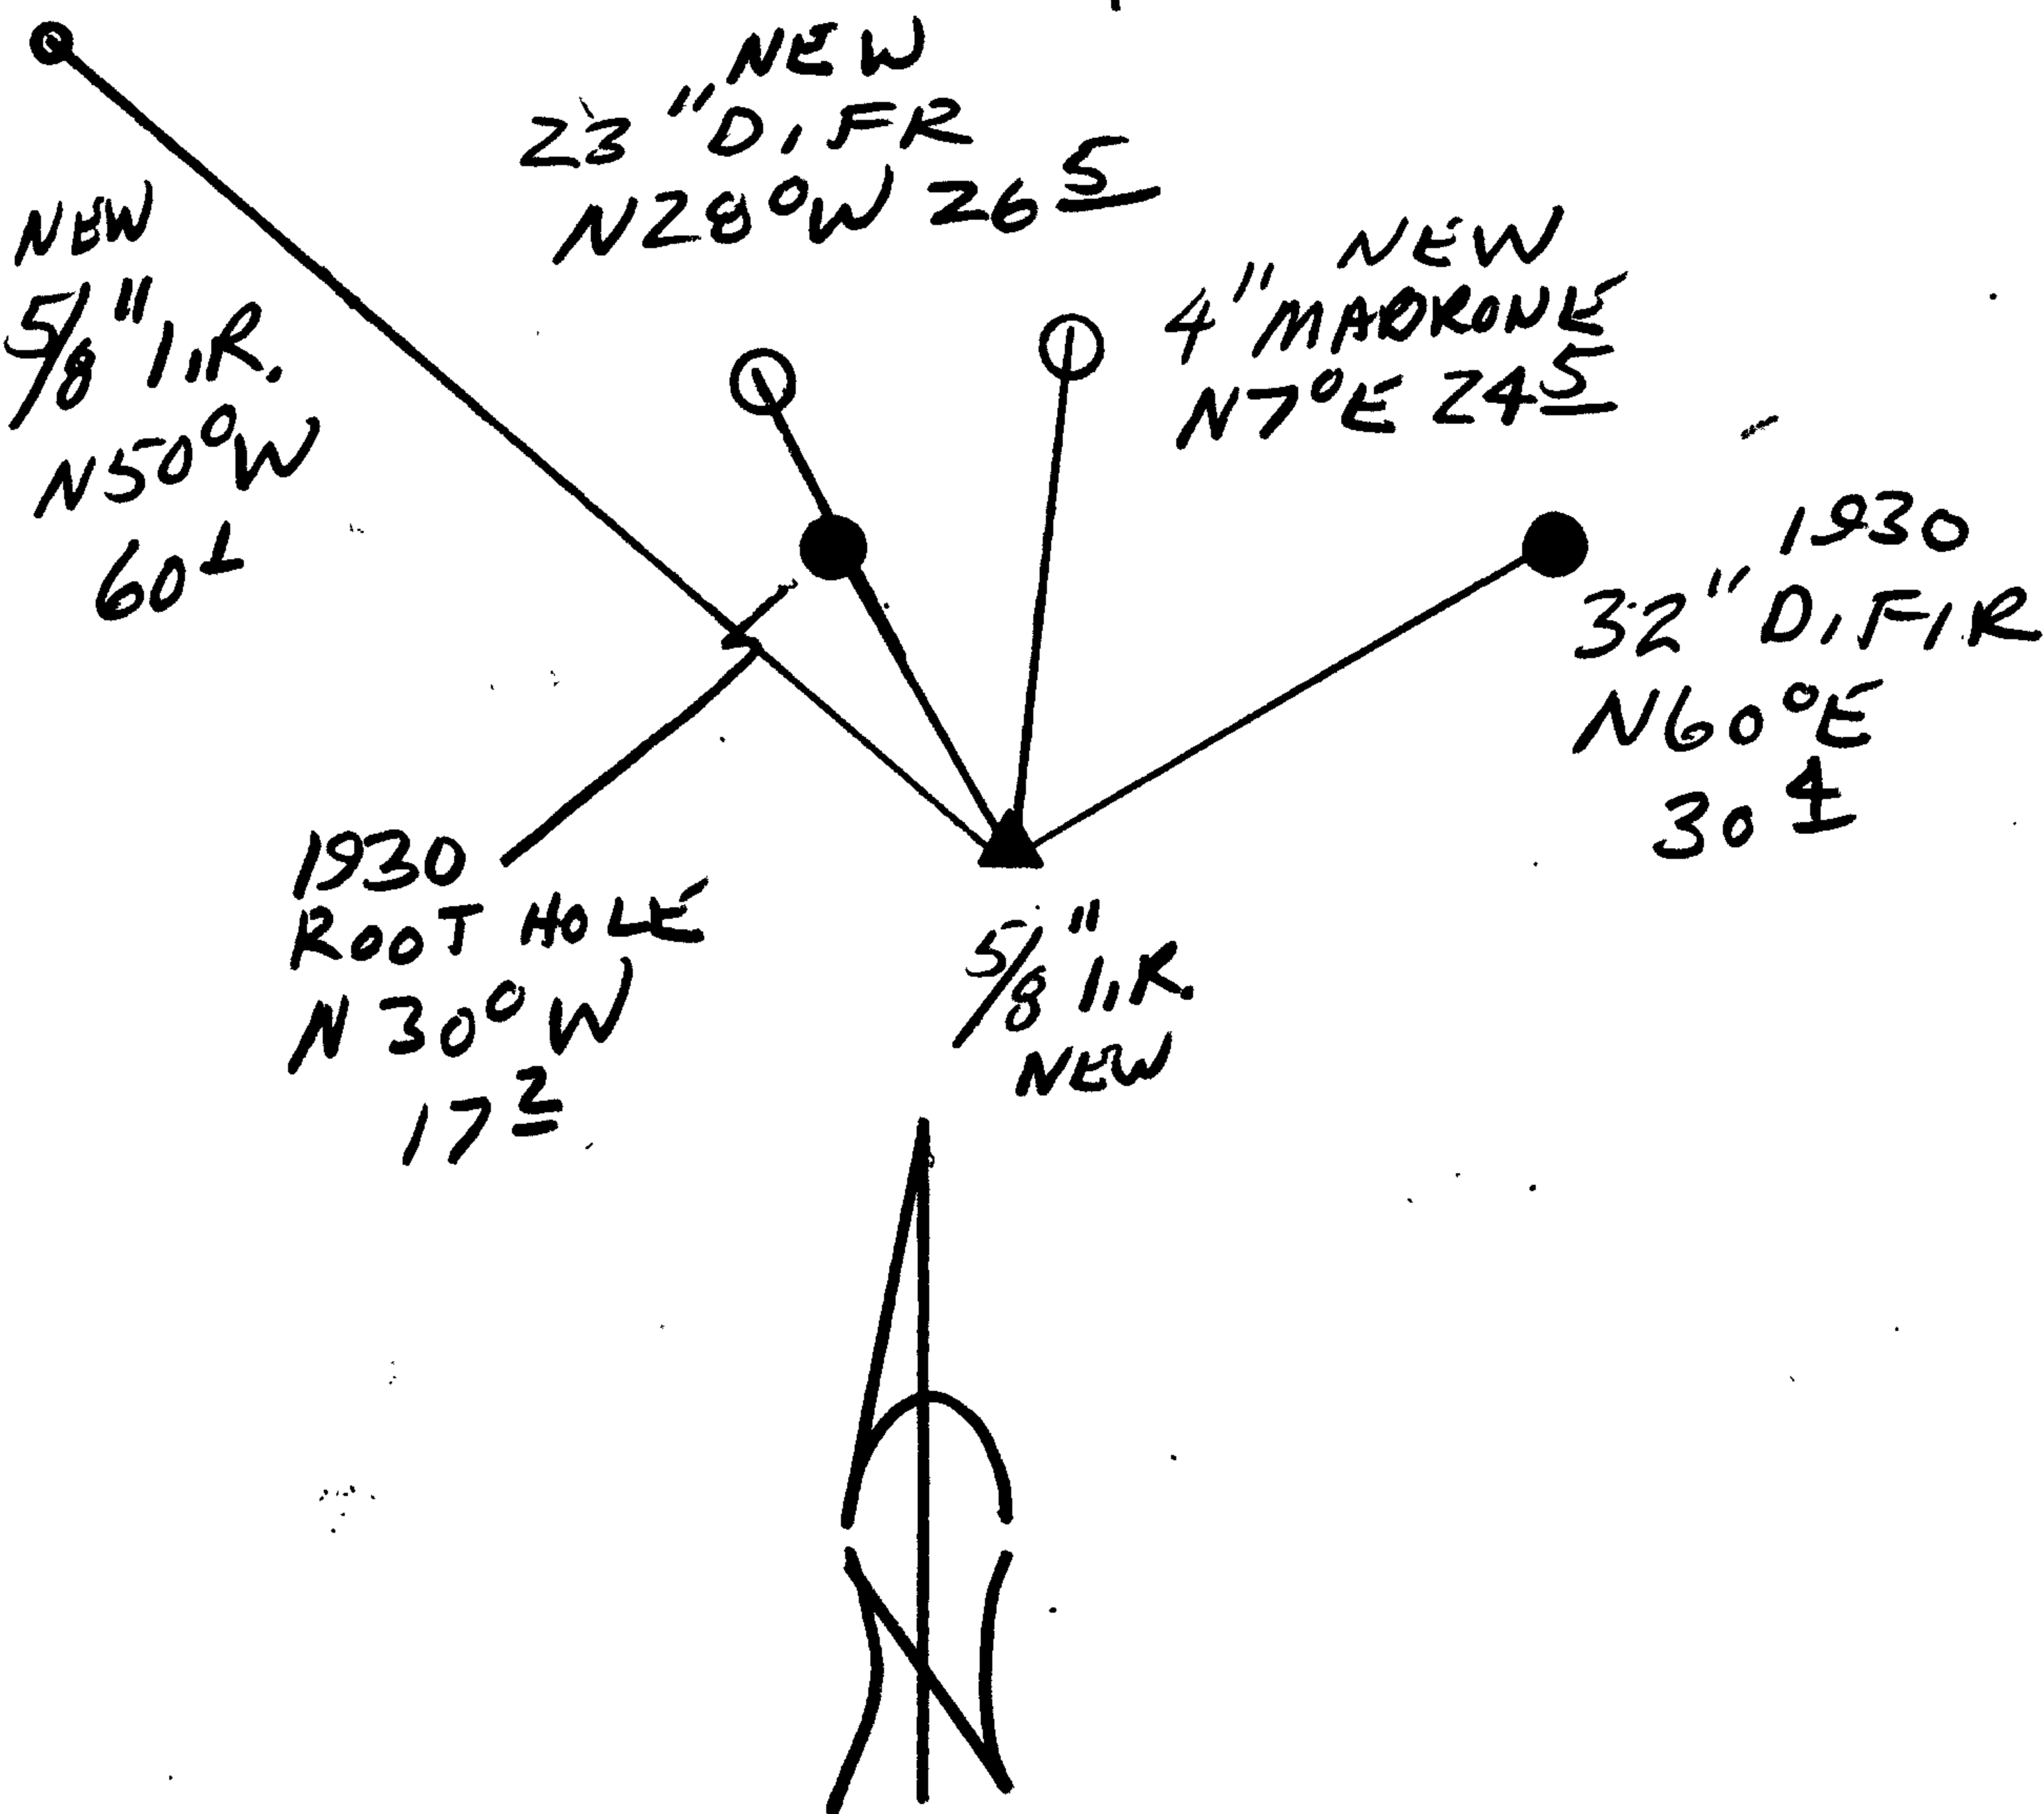

Location & Comments

CORNER LIES 40 FT NORTH OF S TO HIGH WAY WITHIN R/W CUT BANK

Comp. Declin. 17 3/4 °E
Agency DCSO
Party Chief RANDALL W. SMITH
Notekeeper RANDALL W. SMITH
Witnesses STEPHEN J. FLAUS

Address

Surveyor's Seal

REGISTERED PROFESSIONAL LAND SURVEYOR

Randall W. Smith
EXPIRES 6-30-2010

OREGON
JULY 26, 1990
RANDALL W. SMITH
2469