

GOVERNMENT CORNER RESTORATION FORM

Date: 11-3-1999 By: X

This survey consists of:

Township 27S Range 7W Sec. 9

County DOUGLAS Map: _____

State OR

Date 4-6-99

No. 400540.012

Narrative: _____

Corner Apt: 66/12-18

Corner Designation

1/4 S9 | S10

DOUGLAS COUNTY

- Condition Report Only
- Not Found
- Renewed
- Unrecorded
- Surveyed In
- Referenced Out

Previous Renewals 1960 DCSD

MONUMENT DETAIL

Monument(s) Found: (Condition and Source)

2 1/2" DIA BRASS CAP ON A 1 1/2" O.D. IRON PIPE, PROTRUDES 15" ABOVE GROUND 1960

10" X 8" X 16" STONE FOUND FIRMLY SET AND PLUMB. PROTRUDES 6" ABOVE GROUND. NO MARKS FOUND, BEARS N 52° W, 1.8 FT. ~~ASSUMED~~ SET BY BRIGGS IN 1884? SEE VOL 1 PG 39-40 THIS CORNER SHOWN AS A FOUND ROCK IN 1913 BY FRANK CAIN, DEERINGS ADD. TO EDEN ORCHARDS SUBD. VOL 2 PG 3

COUNTY SURVEYORS OFFICE
T27S R7W

1/4 S9 | S10
1960

Accessories Found:

BRG & DIST TAKEN FROM RC/IP
10" NOW 16" DIA 4 FT HIGH O. FIR STUMP WITH FULLY HEALED DOUBLE BLAZE, BEARS S 32° E, 38.4 FT (AGREES WITH REC) 1960
19" NOW 24" DIA 1 FT HIGH O. FIR STUMP WITH A FULLY HEALED BLAZE, BEAR S 33° W, 23.5 FT (AGREES WITH REC) 1960

BOTH CRT'S NOW GONE

RENEWAL

Monument Set (Procedure and Description)

Monument Detail

NONE

N/A

5205
1775

BKG + DIST TAKEN FROM B4/1P

New Accessories

5" DIA MAORONE BARK SCRIBED "Y4S9CSBT"

BEARS S172°W, 24.4 FT

10" DIA B. OAK DOUBLE BLAZED AND SCRIBED "Y4S10CSBT"

BEARS S39°E 31.0 FT


4" DIA. D. FIR DOUBLE BLAZED AND SCRIBED "XCSBT"

BEARS N67°E 30.3 FT

13" DIA. D. FIR DOUBLE BLAZED AND SCRIBED "Y4S9CSBT"

BEARS S94°W, 77.6 FT

Sketch of Monument, Accessories, and General Area

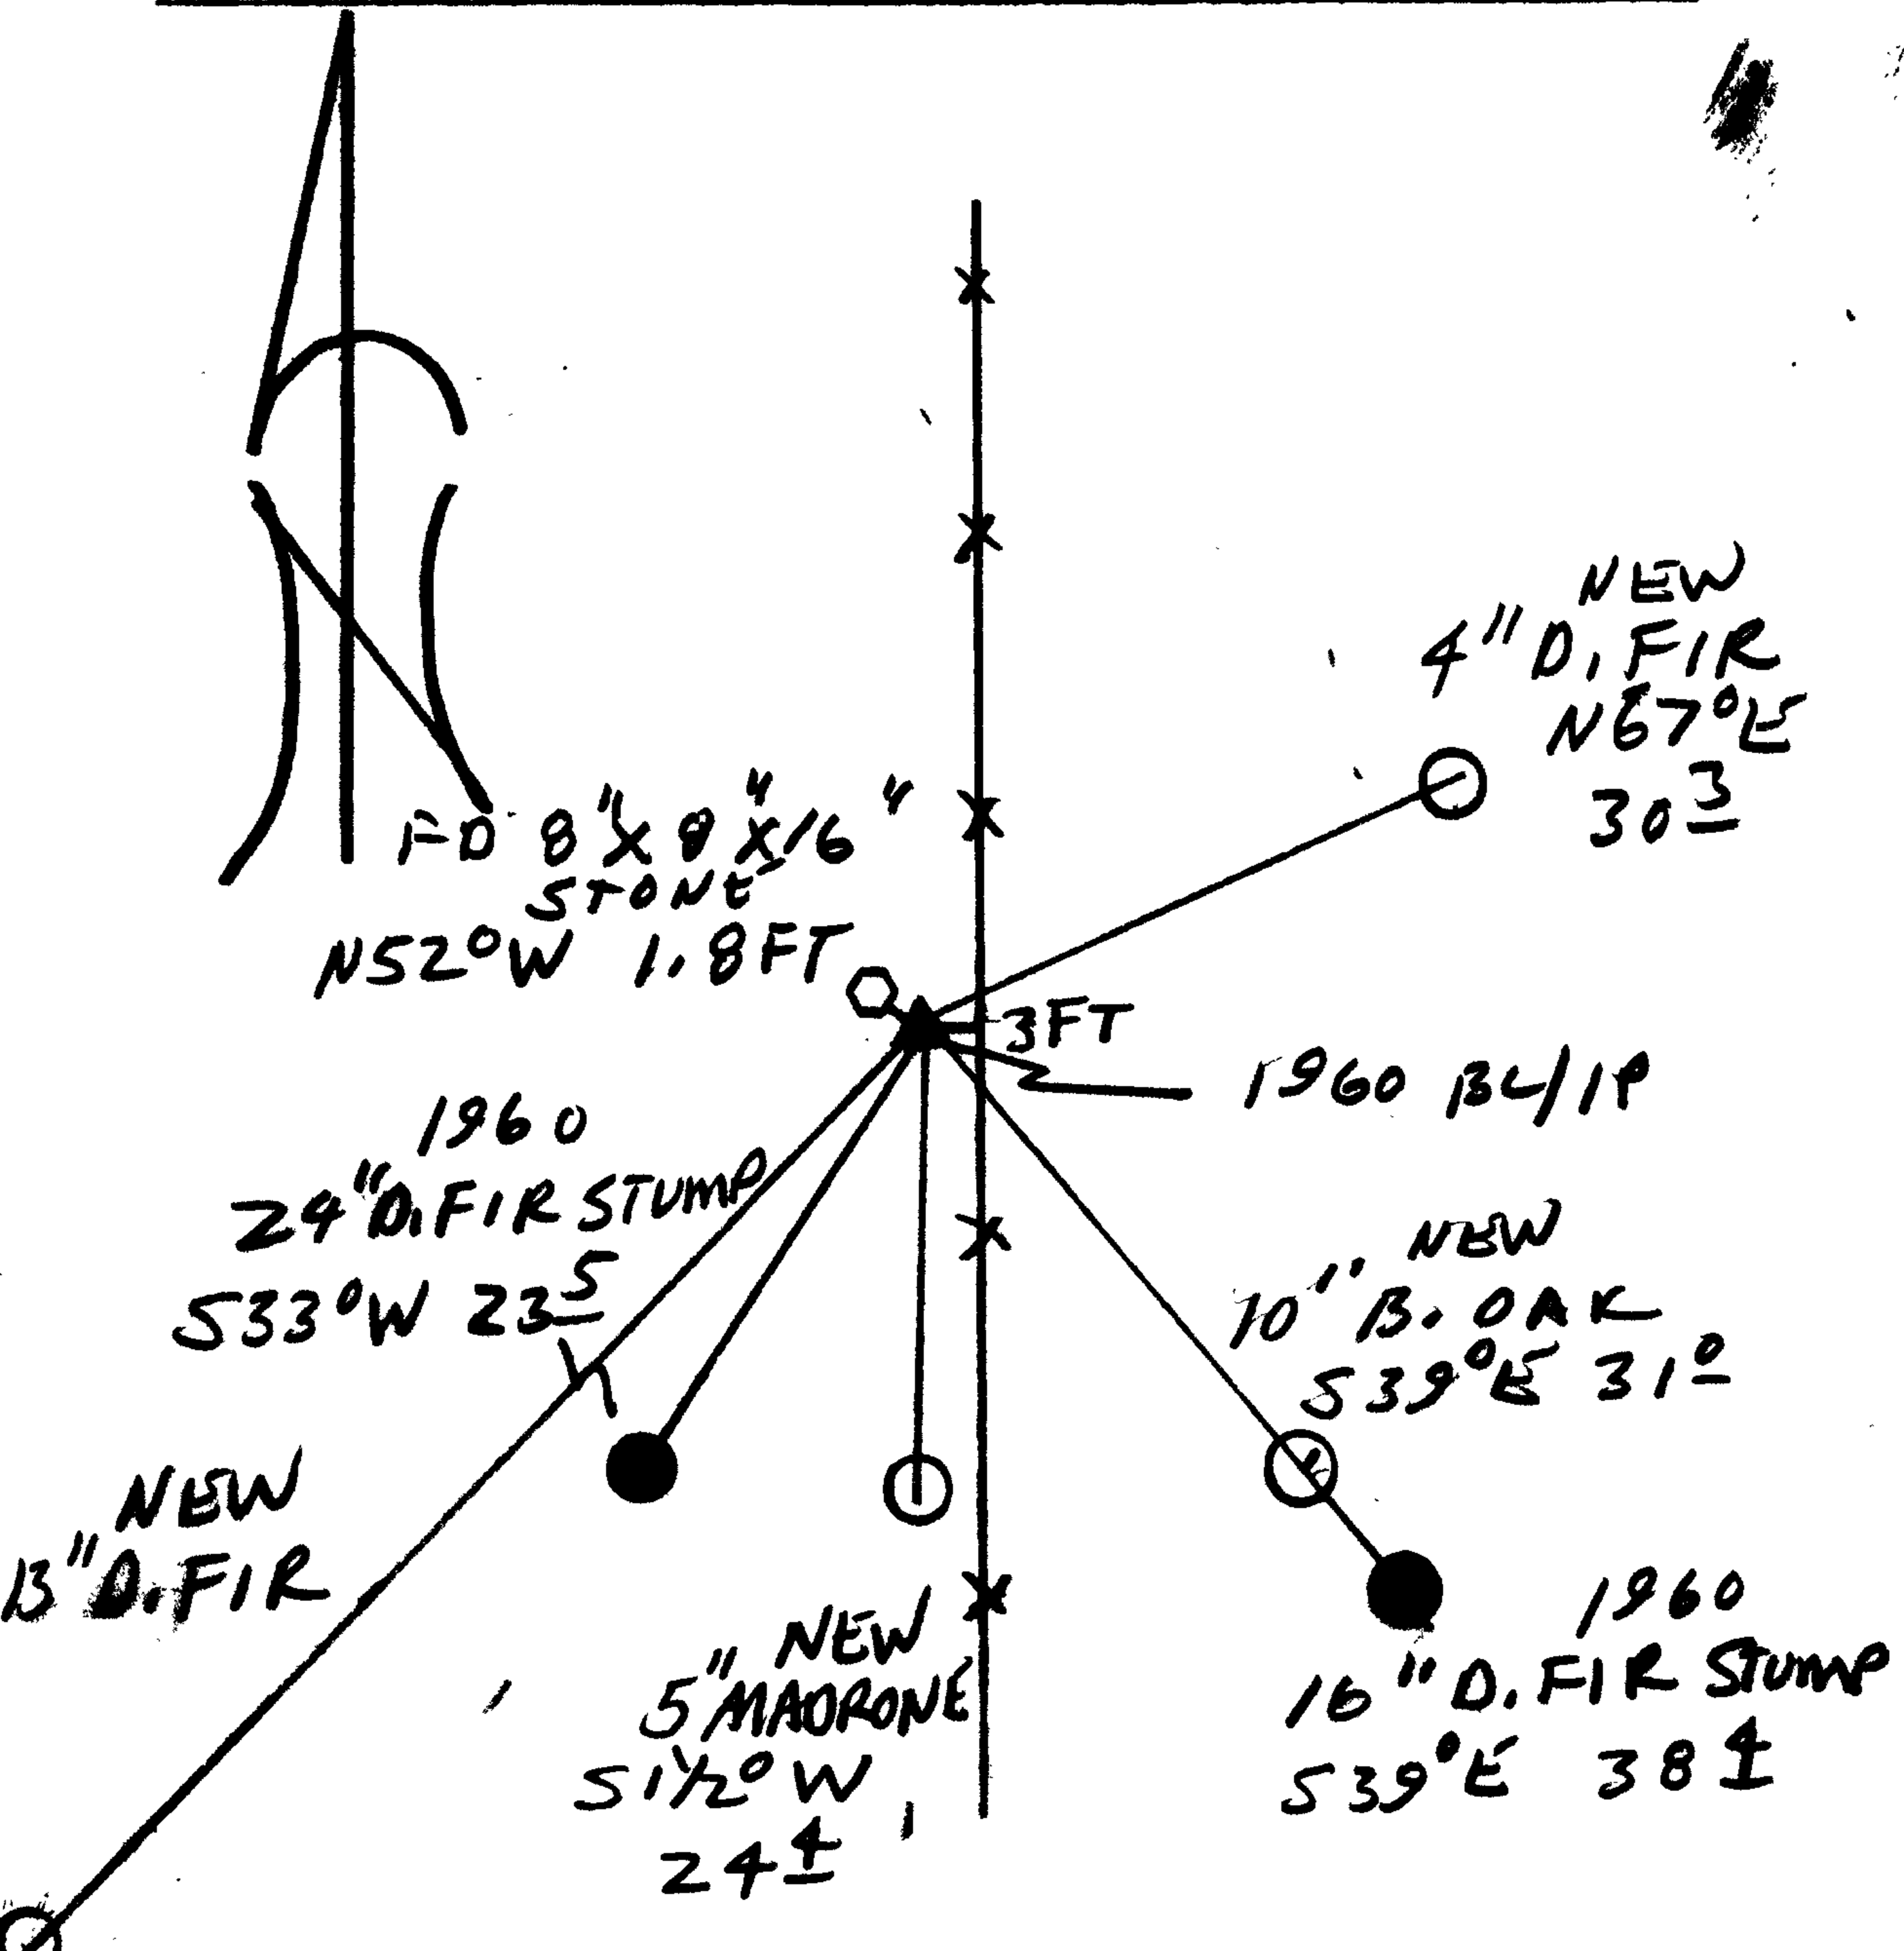

Location & Comments

CORNER LIES 3 FT WEST OF A N-S FENCE LINE

Comp. Declin. 17 3/4° E

Agency DCS

Party Chief RANDALL W. SMITH

Notekeeper [Signature]

Witnesses STEPHEN FRAUSE

Address

REGISTERED PROFESSIONAL LAND SURVEYOR

[Signature] BEARS 6-30-7000

OREGON JULY 25, 1960 RANDALL W. SMITH 2489