

GOVERNMENT CORNER RESTORATION FORM

Date: 11-3-1999 By: JC

Township 30S Range 6W Sec. 3

County DOUGLAS


This survey consists of:
Map: _____

State OR Date 9-20-99

No. 4001100.024

Narrative: _____

Corner Designation

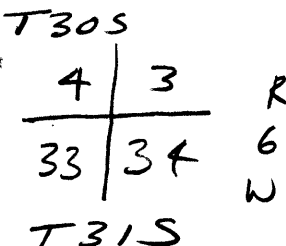

Corner Rpt: 66/12-29

- DOUGLAS COUNTY
SURVEYOR
- Condition Report Only _____
 - Not Found _____
 - Renewed
 - Unrecorded _____
 - Surveyed In _____
 - Referenced Out _____

Previous Renewals 1955 MARKHAM, 1960 DCSC

Monument(s) Found: (Condition and Source)

3/4" I.D. IRON PIPE, PROTRUDES
10" ABOVE GROUND. 1955

N/A

Accessories Found:

14" NOW DOWN AND ROTTED MADRONE, BEARS N74°E,
46.5 FT. (AGREES WITH REC.) 1955

N 35°W AND N 22°E BT'S FROM 1955 NOW
GONE

9" NOW 14" DIA. W. OAK WITH A FULLY HEALED
DOUBLE BLAZE, BEARS S10°W, 51.97 FT
(AGREES WITH REC.) 1960

1960 SE BT GONE

RENEWAL

Monument Set (Procedure and Description)

Monument Detail


NONE

N/A

New Accessories

- 13" MADRONE SINGLE BLAZED AND SCRIBED "T30S R6WS33CSBT" BEARS N36°W 26.0 FT
- DOUBLE TRUNKED B.OAK DOUBLE BLAZED AND SCRIBED "T34S R6WS33CSBT" ON 6" DIA NORTHERLY TRUNK, CENTER BASE OF NORTHERLY TRUNK, BEARS S87 1/2°E 14.9 FT
- 5" D. FIR DOUBLE BLAZED AND SCRIBED "XCS BT" BEARS N74°E, 53.3 FT

Sketch of Monument, Accessories, and General Area

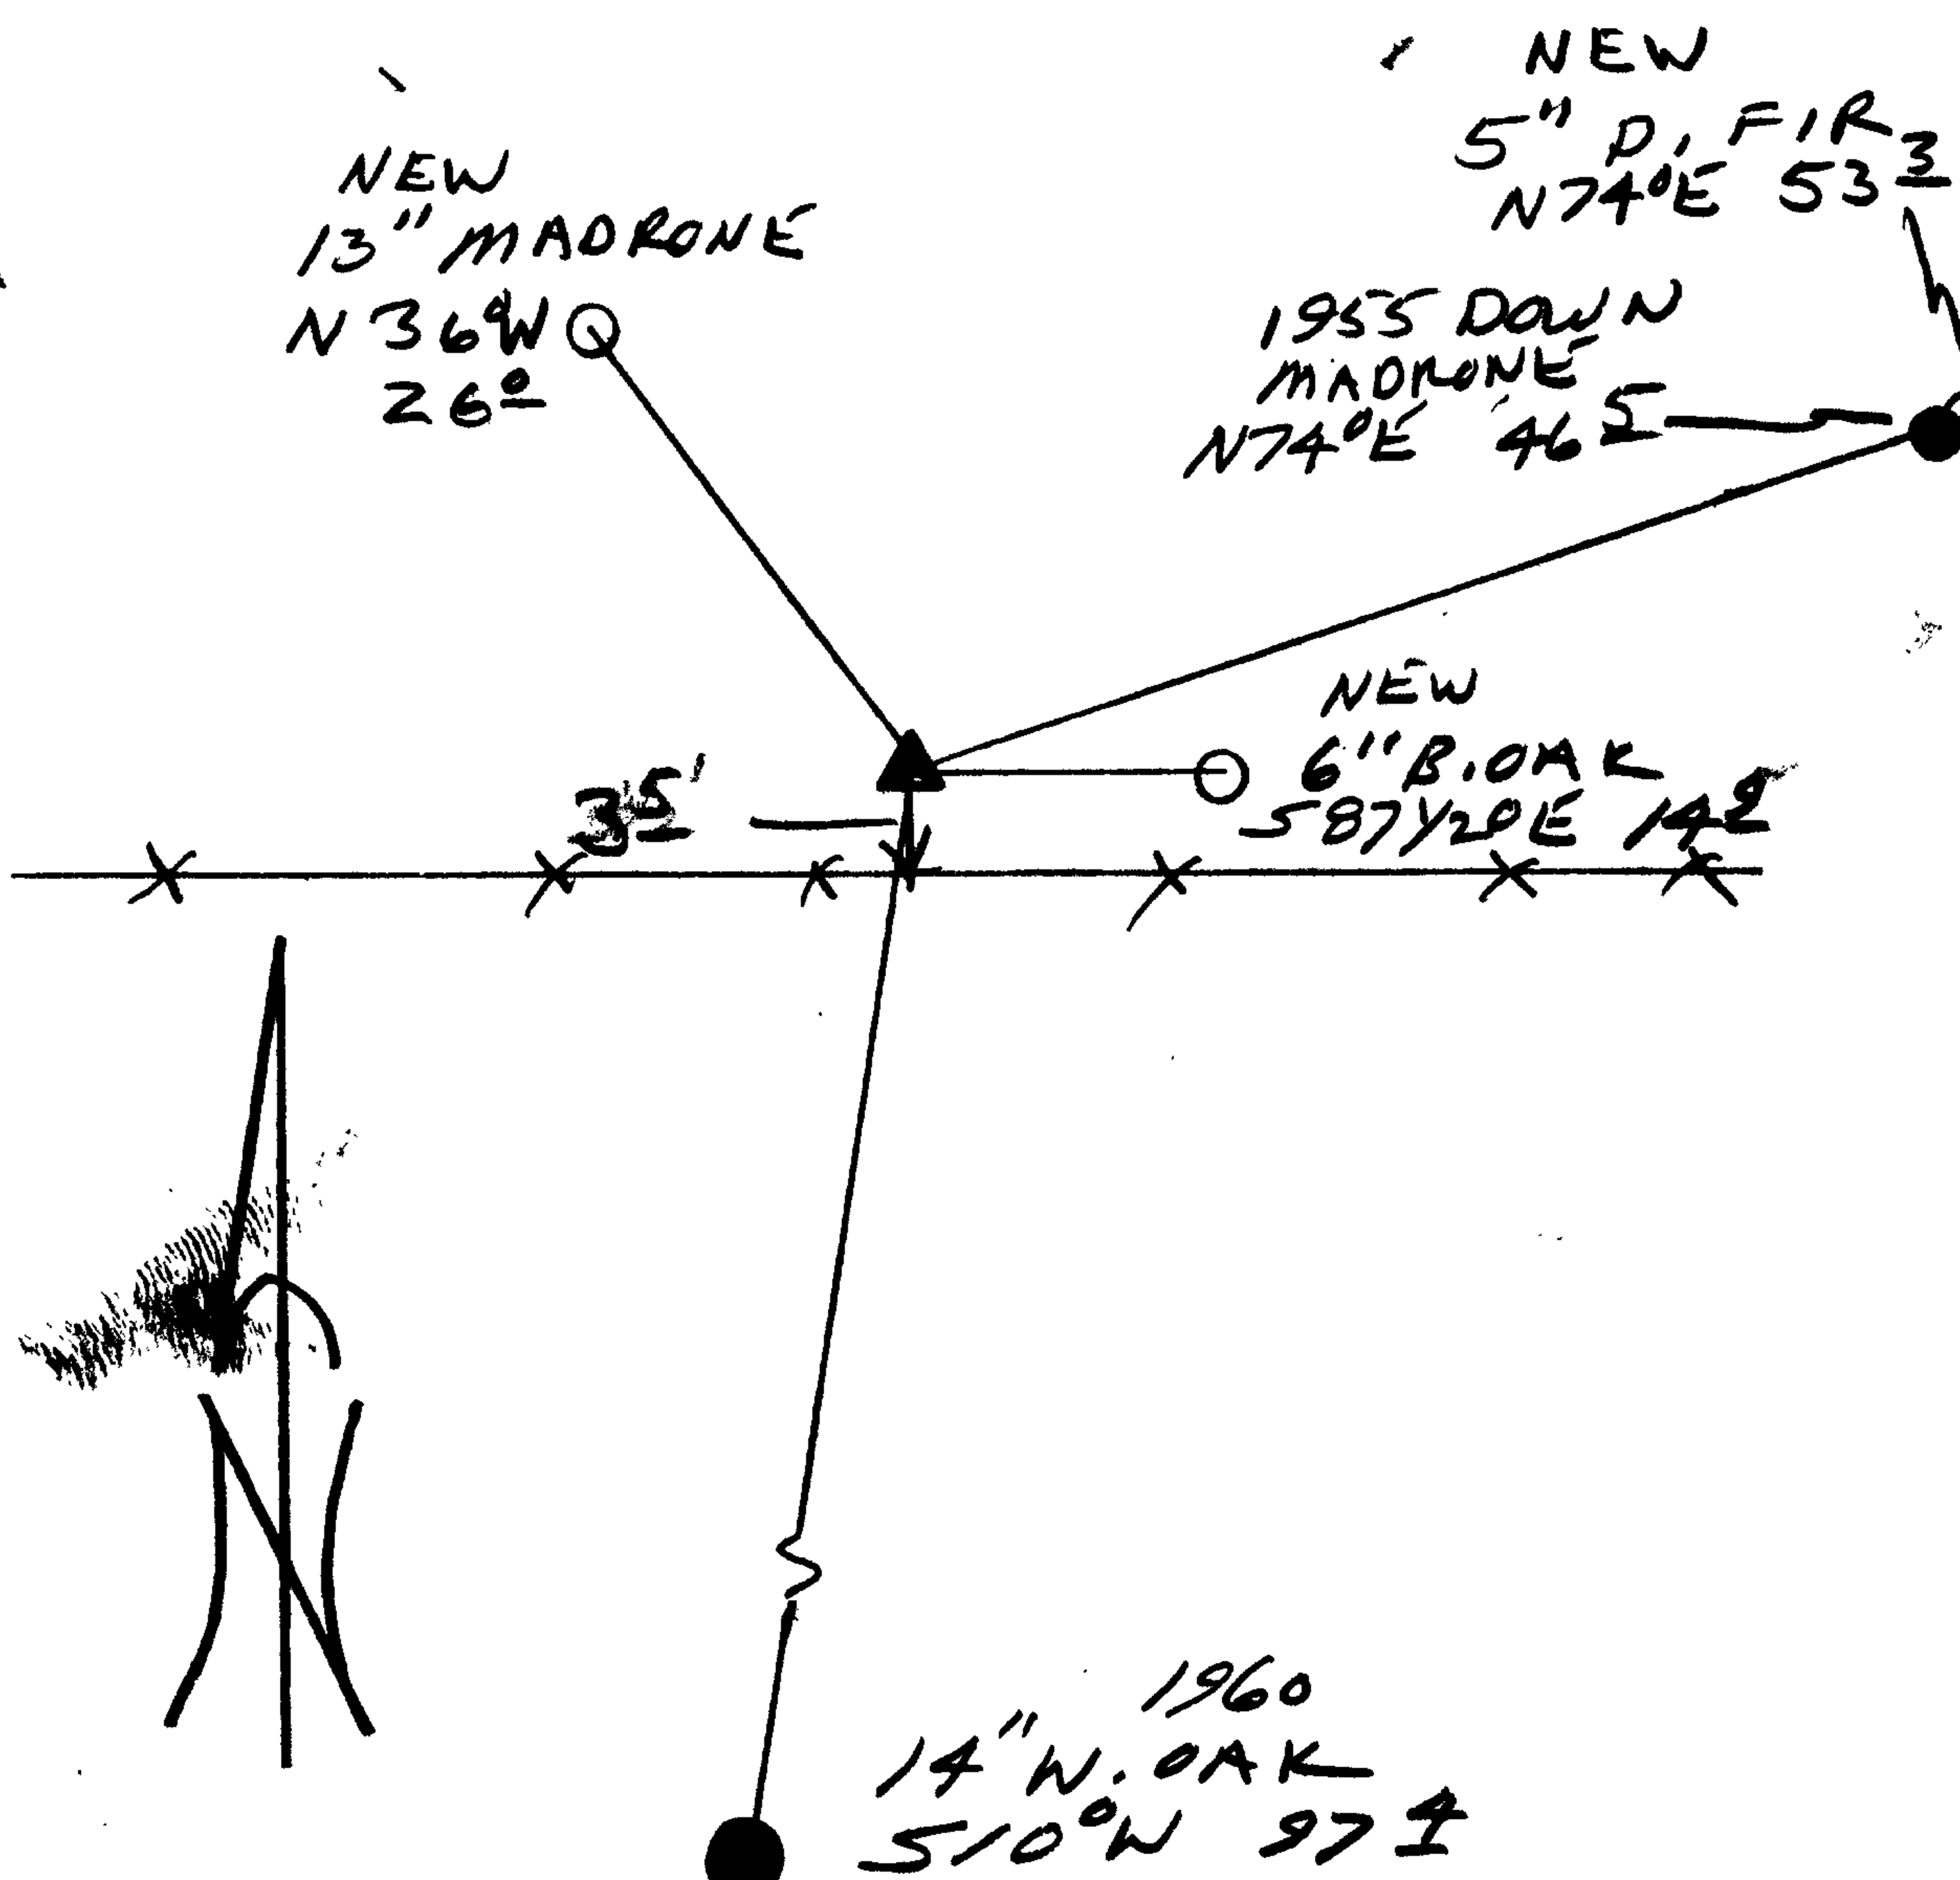

Location & Comments

CORNER LMS 3 1/2
 NORTH OF AN EAST-
 WEST FENCE LINE
 4-WAY FENCE CORNER
 NOTED IN 1960 NOW
 GONE

Comp. Declin. 17 3/4°E
 Agency PCSO
 Party Chief RANDALL W. SMITH
 Notekeeper [Signature]
 Witnesses STEPHEN J. FLANK

Address

Surveyor's Seal

REGISTERED
 PROFESSIONAL
 LAND SURVEYOR

[Signature]
 EXPIRES 6-30-2000

OREGON
 JULY 26, 1990
 RANDALL W. SMITH
 2469