

Date: 11-3-1999 By: JC

GOVERNMENT CORNER RESTORATION FORM

This survey consists of:

Township 28S Range 8W Sec. 32 County DOUGLAS Map: \_\_\_\_\_  
State OR Date 9-21-99 No. 240100-107 Narrative: \_\_\_\_\_  
Corner Rpt: 166/12-30

Corner Designation

$\frac{1}{4} \frac{532}{55}$

DOUGLAS COUNTY SURVEYOR

- Condition Report Only
- Not Found
- Renewed
- Unrecorded
- Surveyed In
- Referenced Out

Previous Renewals 1957 DCSO

Monument(s) Found: (Condition and Source)

2 1/2" DIA BRASS CAP ON A 1 1/2" O.D. IRON PIPE PROTRUDS 18" ABOVE GROUND / 1957

COUNTY SURVEYORS OFFICE  
T 28S  
 $\frac{1}{4} \frac{532}{55}$  R 8W  
T 29S  
1957

Accessories Found:

40" NOW 60" DIA. D. FIR WITH BARK SCRIBING "YAS" AND OTHER ILLIBLE BARK SCRIBING VISIBLE BLANKS S40°W 7.3 FT TO CENTER OF BARK (REC S40°W, 12.6 FT AGREES WELL WITH ORIG. BARK SCRIBER FACE). OBT

5" NOW 22" DIA 1 1/2 FT HIGH ROTTED FIR STUMP ILLIBLE SCRIBING VISIBLE BLANKS N 35°E, 12.5 FT (AGREES WITH REC.) OBT

RENEWAL

Monument Detail

Monument Set (Procedure and Description)


NONE

N/A

New Accessories

- 7" DIA. G. FIR DOUBLE BLAZED AND SCRIBED "1/4 S32CS BT" BEARS N 84° E, 9.7 FT
- 15" DIA. G. FIR DOUBLE BLAZED AND SCRIBED "1/4 S5CS BT" BEARS S 63 1/2° E, 26.4 FT
- 10" DIA. CHINGUAPIN DOUBLE BLAZED AND SCRIBED "1/4 S32CS BT" BEARS N 18° W, 62.1 FT

Sketch of Monument, Accessories, and General Area

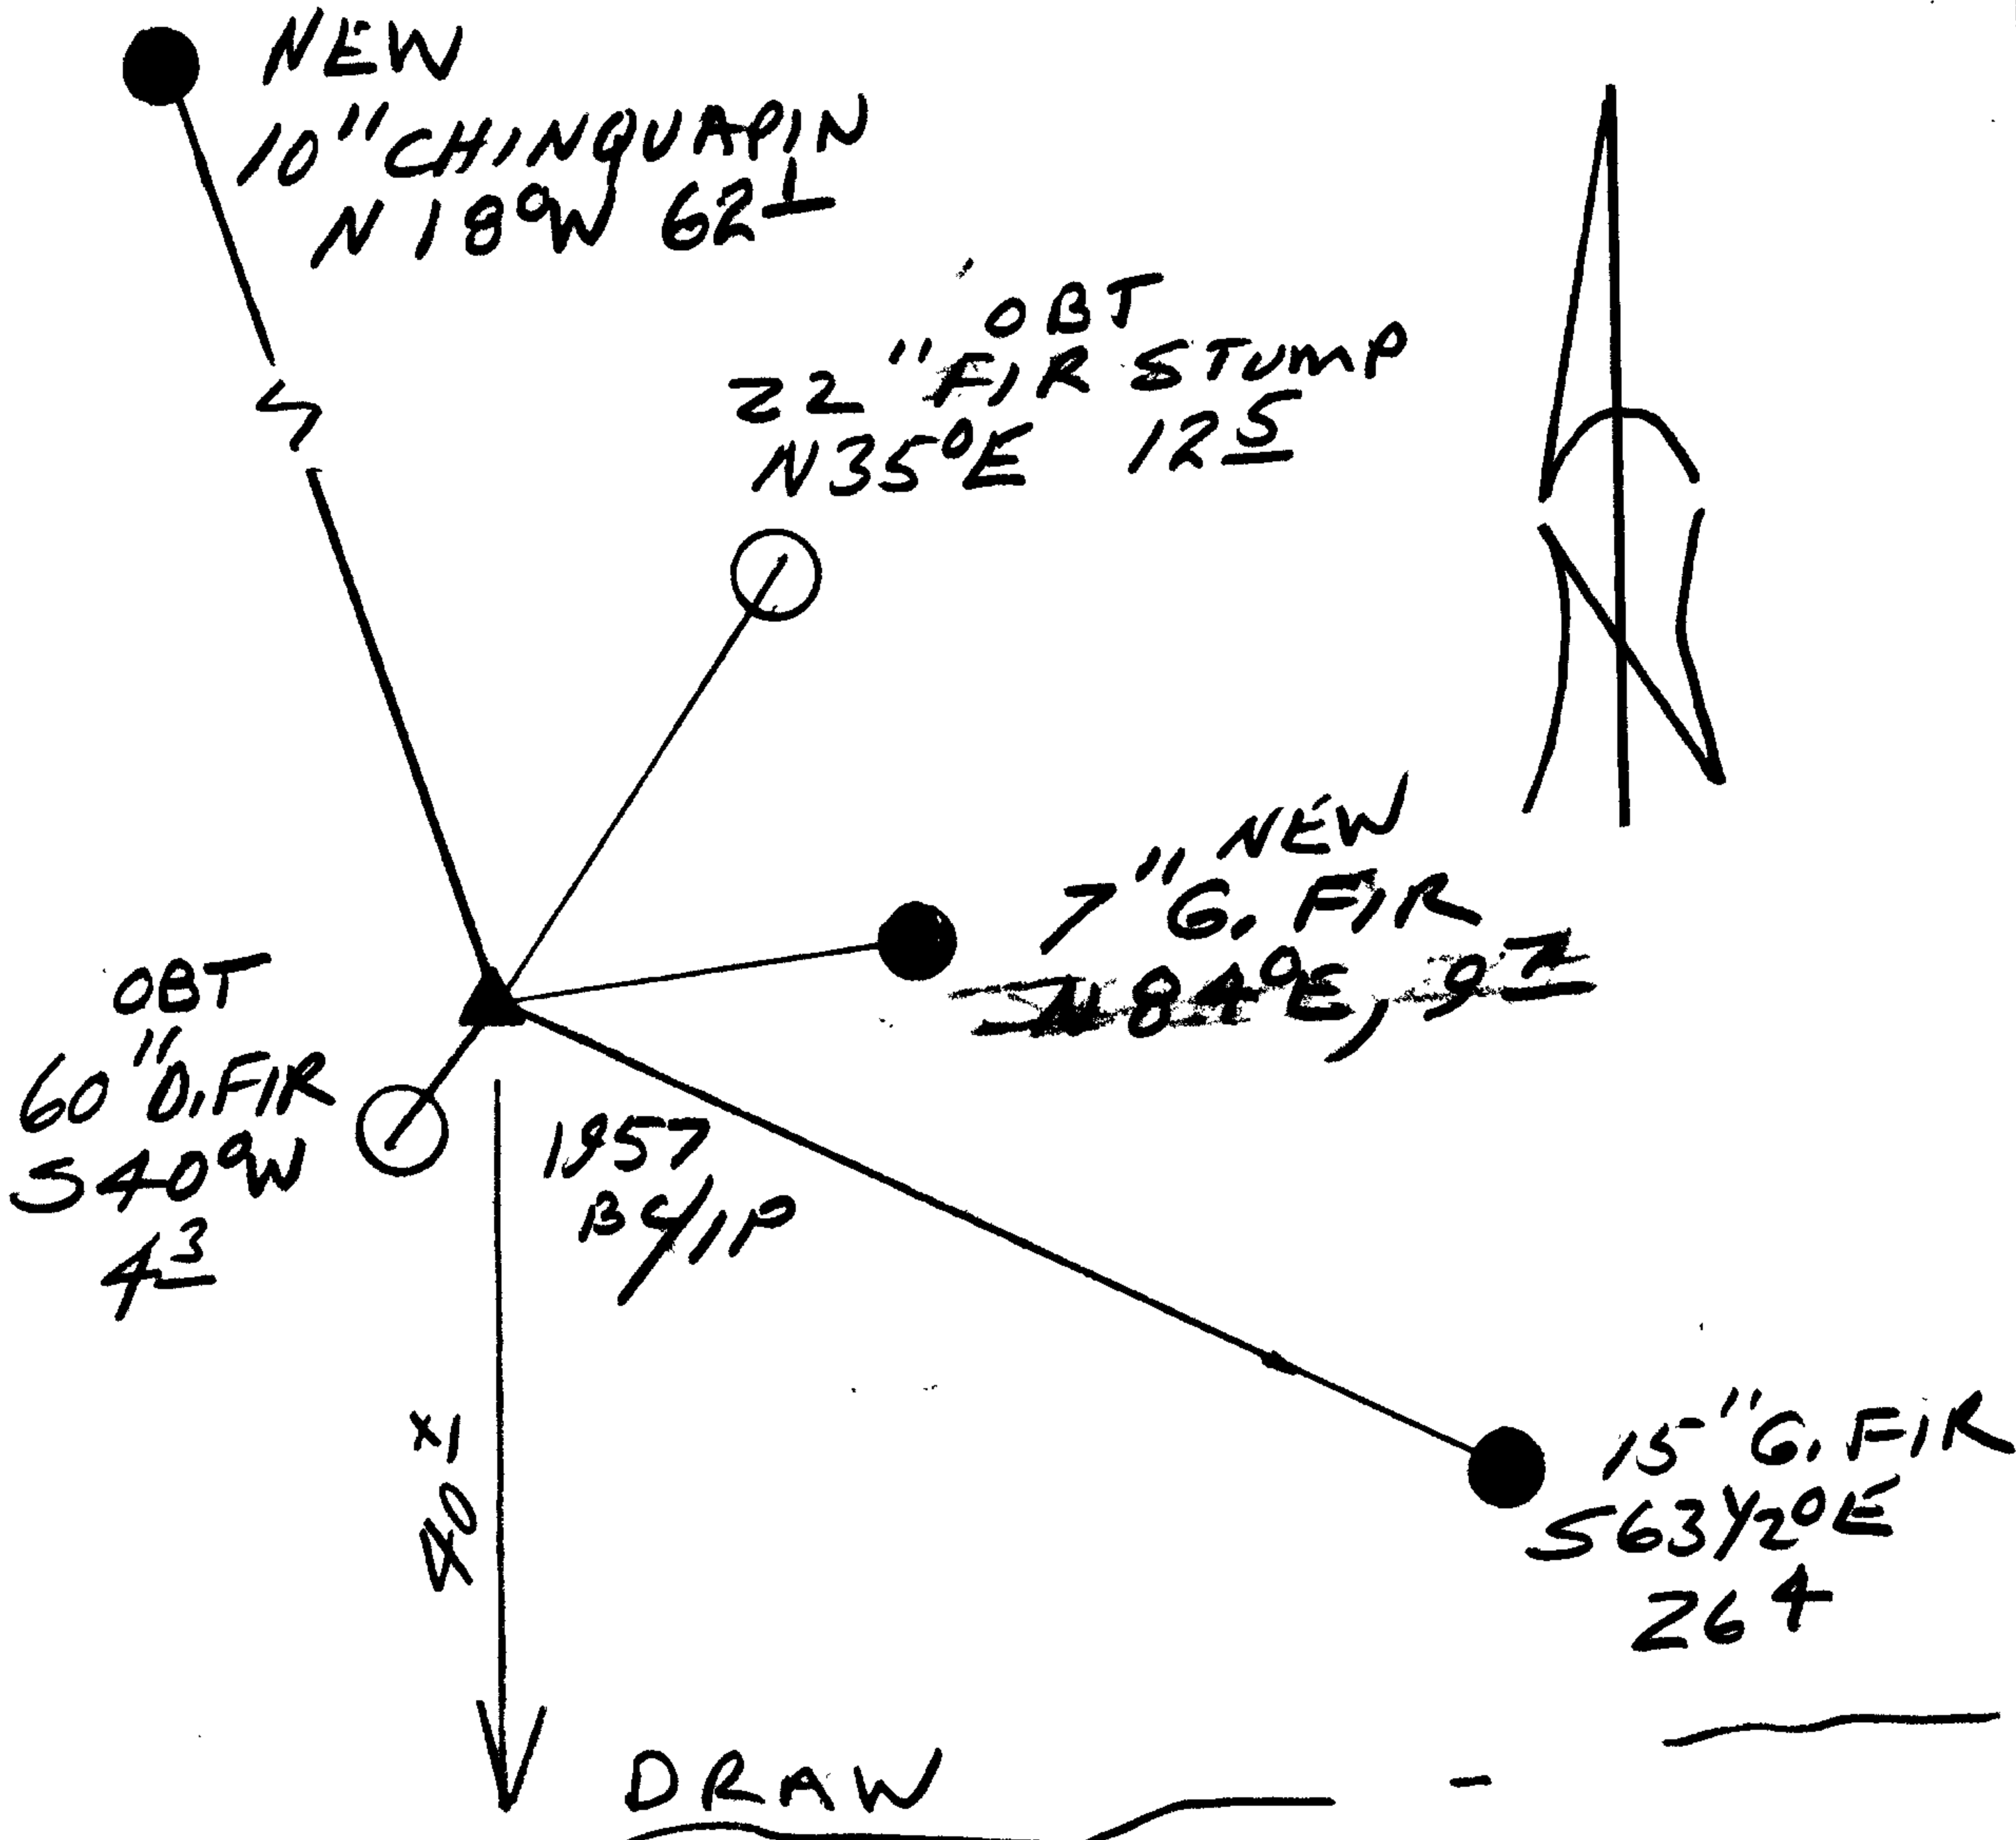

Location & Comments

Comp. Declin. 17 3/4° E  
 Agency DLSO  
 Party Chief RANDALL W. SMITH  
 Notekeeper [Signature]  
 Witnesses STEPHEN J. FLAUSK

Address

Surveyor's Seal

REGISTERED  
 PROFESSIONAL  
 LAND SURVEYOR

[Signature]  
 6-30-2000

OREGON  
 JULY 26, 1990  
 RANDALL W. SMITH  
 2499