



RENEWAL

Monument Set (Procedure and Description)

Monument Detail

NONE


N/A

.19

New Accessories

1/2" I.P. IRON PIPE PROTRUDES 8" ABOVE GROUND BEARS N30°E, 100.9 FT  
 1/2" I.P. IRON PIPE BENT PLUMB POSITION BEARS N38°W, 172.0 FT  
 1" DIA. W. OAK DOUBLE BLAZED AND SCRIBED "NE DLG 46 CS BT"  
 BEARS N 65 1/2° W, 57.8 FT  
 9" DIA. W. OAK DOUBLE BLAZED AND SCRIBED "NE DLG 46 CS BT"  
 BEARS N 53° E, 105.7 FT

Sketch of Monument, Accessories, and General Area

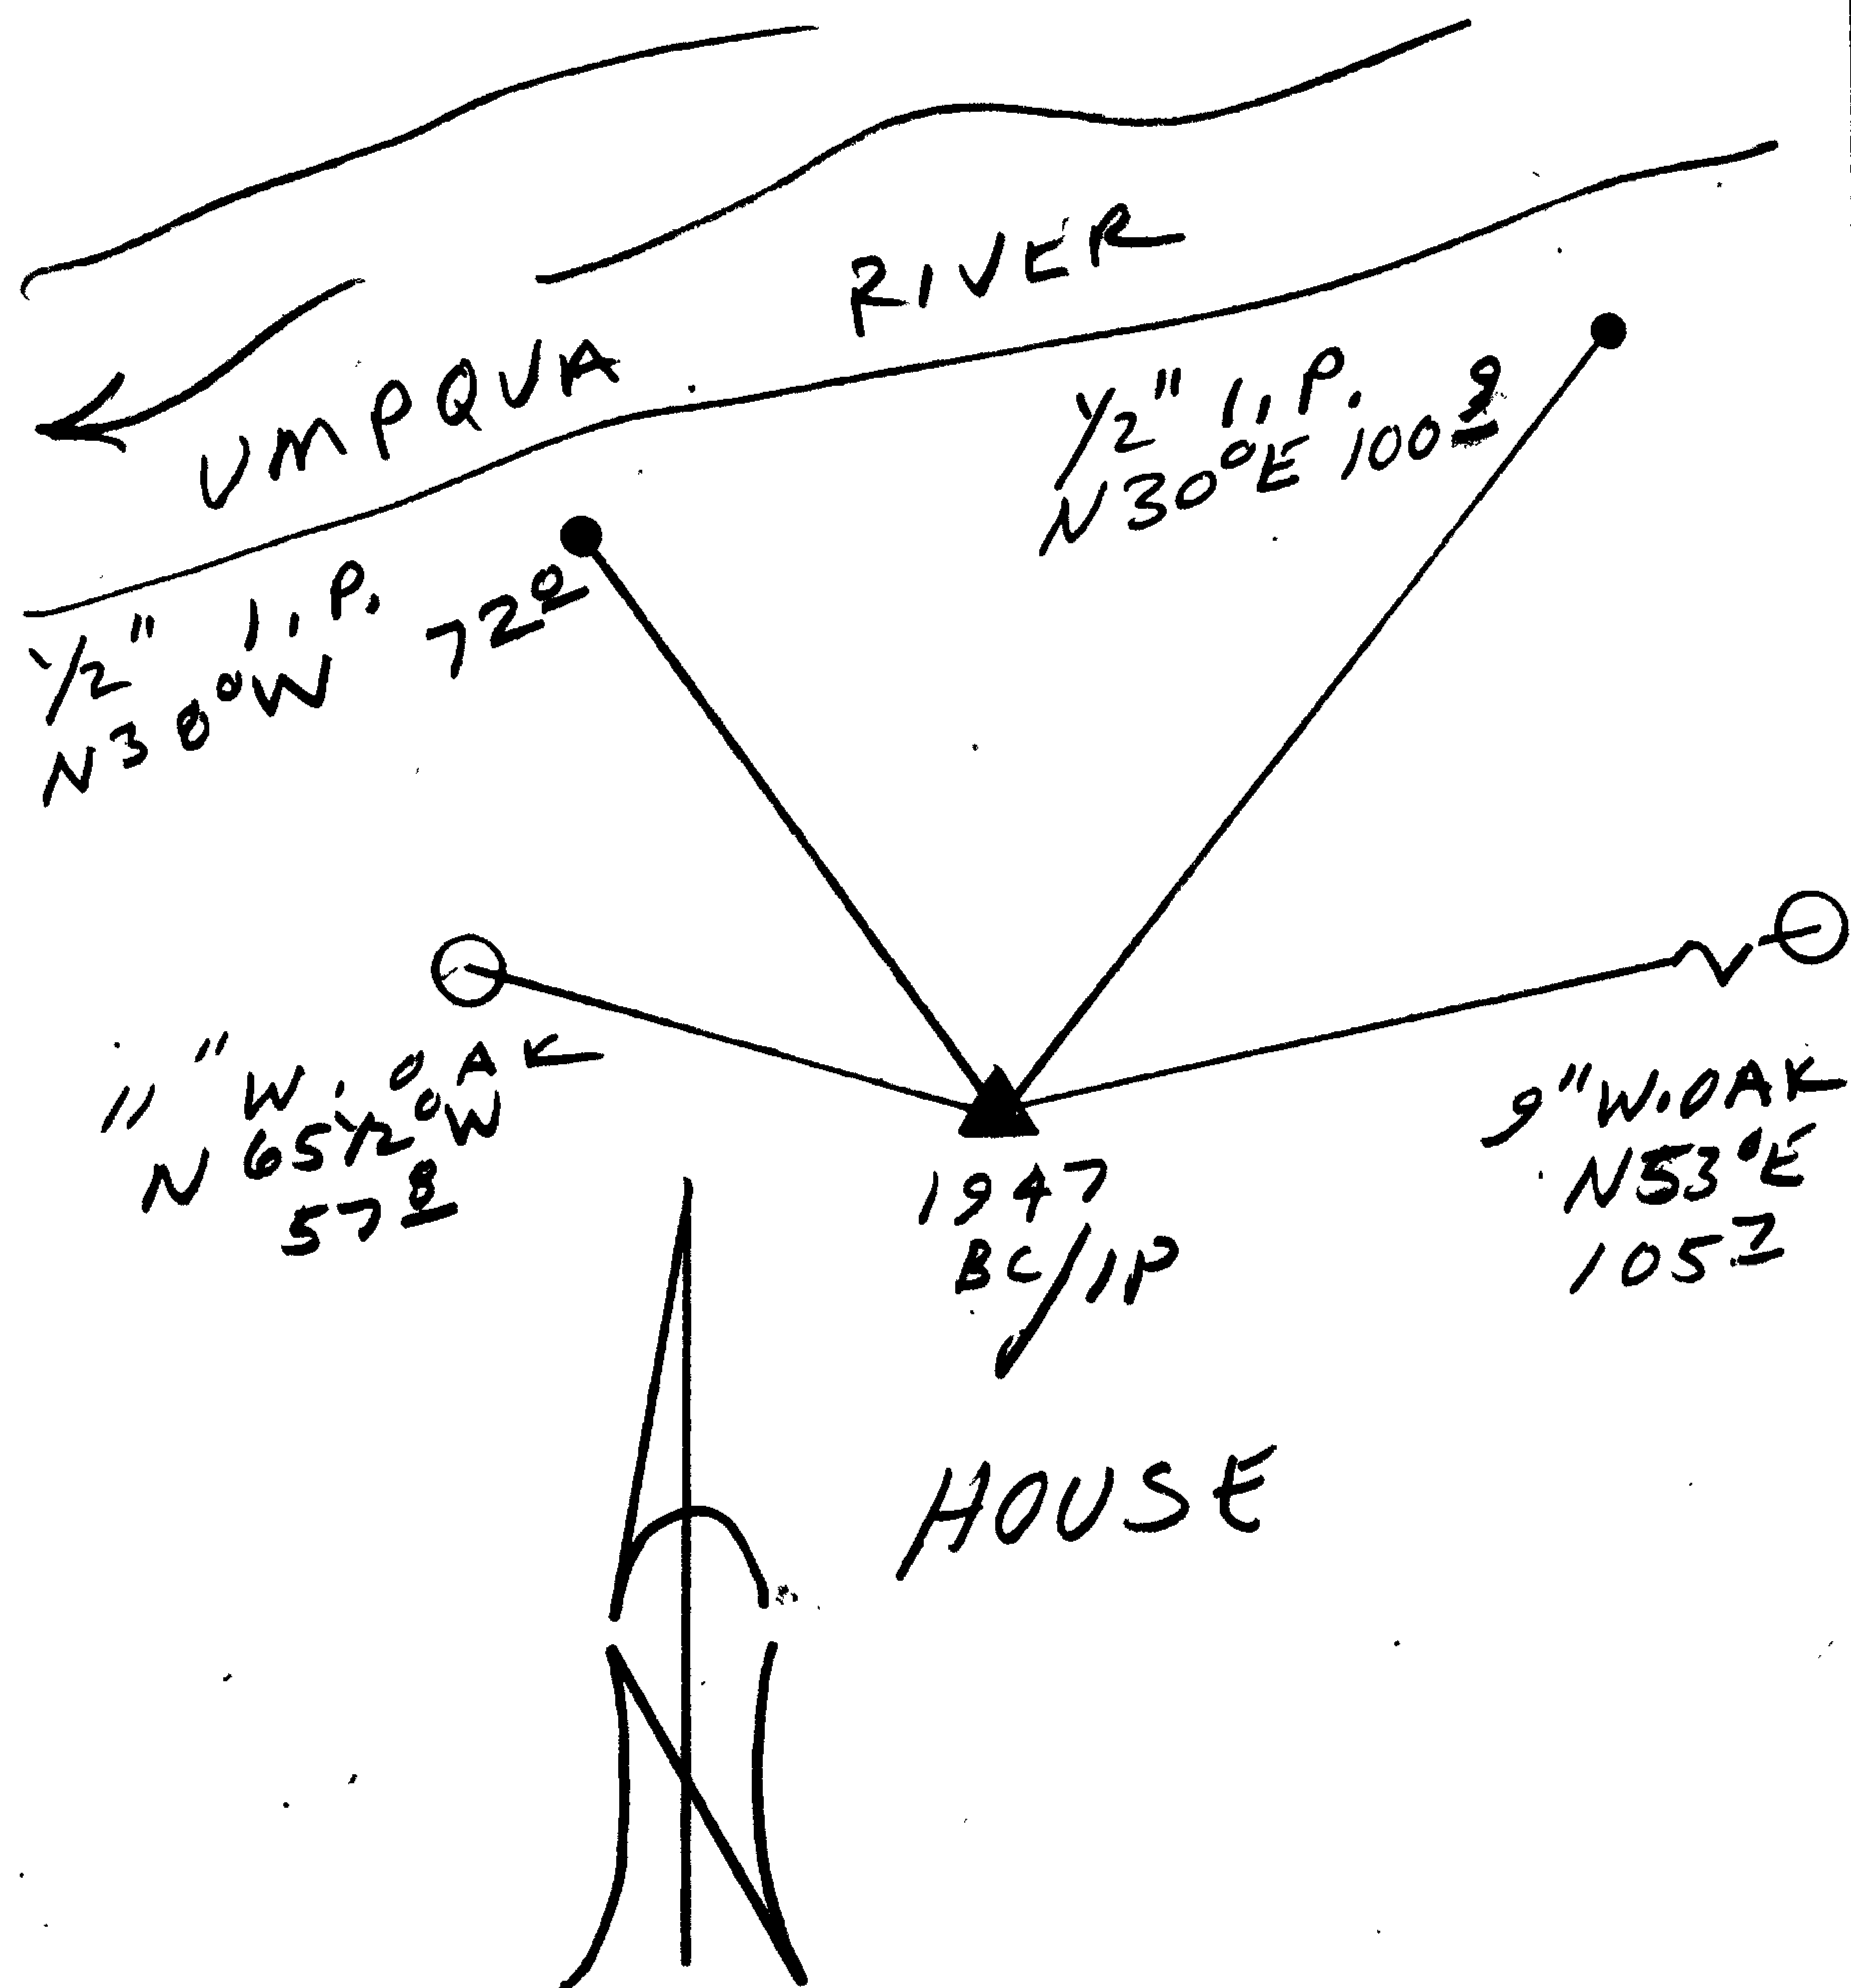

Location & Comments

Comp. Declin. 17 3/4° E  
 Agency DCS  
 Party Chief RANDALL W. SMITH  
 Notekeeper [Signature]  
 Witnesses STEPHEN J. FLAISE

Address

Surveyor's Seal

REGISTERED  
 PROFESSIONAL  
 LAND SURVEYOR

[Signature]  
 EXPIRES 6-30-2000

OREGON  
 JULY 25, 1990  
 RANDALL W. SMITH  
 2488