

FILED

Date: 11-17-1999 By: SC


This survey consists of:

Map: _____

Narrative: _____

Corner Rpt: 66/12-38

DOUGLAS COUNTY
SURVEYOR

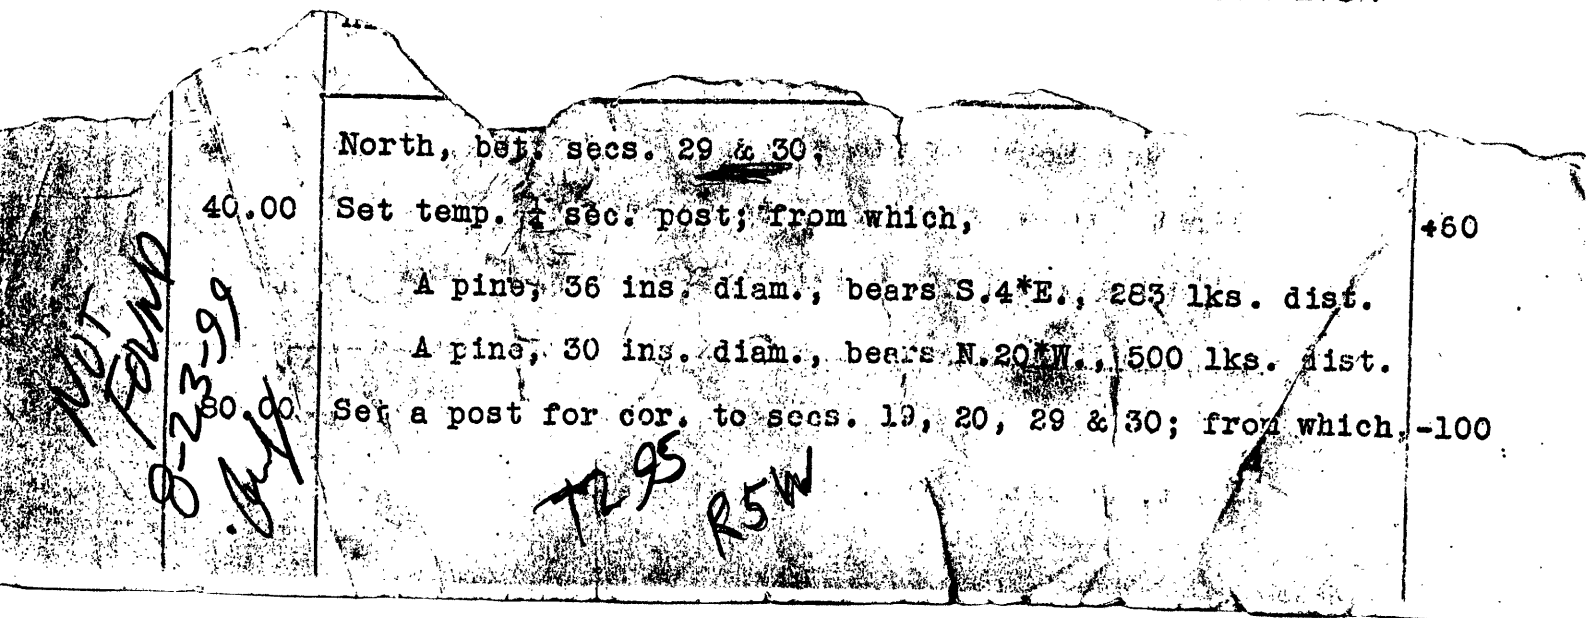

200240.019

C.S. File No. 66/12-38