

GOVERNMENT CORNER RESTORATION FORM

Date: 11-17-1999 By: JC

Township 285 Range 4W Sec. 27

County DOUGLAS

This survey consists of:

State OR

Date 9-15-99

No. \_\_\_\_\_

Narrative: \_\_\_\_\_

Corner Rpt: 66/12-40

Corner Designation

$\frac{1}{4}$  S 27  
S 34

DOUGLAS COUNTY

Condition Renewed Only

Not Found

Renewed

Unrecorded

Surveyed In

Referenced Out

MONUMENT DETAIL

Previous Renewals 1922 DCSO, 1981 BLM

Monument(s) Found: (Condition and Source)

3 1/4" DIA BLM BRASS CAP ON  
A 7 1/2" D.D. IRON PIPE, PROTRUDES  
7" ABOVE GROUND. 1981

U. S. DEPT. OF THE INTERIOR  
T28S R4W

$\frac{1}{4}$  S 27  
S 34

1981

BUR. OF LAND MANAGEMENT

Accessories Found:

30" NOW 36" DIA 2 FT HIGH ROTTED D. FIR STUMP  
WITH SCRIBING "BT" VISIBLE BEARS N 89° E,  
20.2 FT (AGREES WITH REC.) 1922

24" NOW 30" DIA 5 FT HIGH ROTTED MAPLE  
SNAG WITH A ROTTED BLAZE BEARS S 11° W  
46.5 FT (AGREES WITH 1981 BLM REC.) 1922

8" NOW 10" DIA 1 FT HIGH CEDAR STUMP  
WITH AN UNHEALED BLAZE, SCRIBING "4 S 27 BT"  
VISIBLE, BEARS N 45 1/4° E, 16.2 FT (AGREES WITH  
REC.) 1981

16" NOW 18" DIA 1 1/2 FT HIGH D. FIR STUMP  
WITH A FULLY HEALED BLAZE BEARS S 47 1/2° E,  
34.3 FT. (AGREES WITH REC.) 1981

C.S. File No. 66/12-40

RENEWAL

Monument Set (Procedure and Description)

NONE


Monument Detail

N/A

New Accessories

- 6" I. CEDAR DOUBLE BLAZED AND SCRIBED "Y4S34CS BT"  
BEARS S65°E, 7.4 FT
- 8" D. FIR DOUBLE BLAZED AND SCRIBED "Y4S34CS BT"  
BEARS S8°W, 7.8 FT
- 16" D. FIR DOUBLE BLAZED AND SCRIBED "Y427CS BT"  
BEARS N12°W, 8.9 FT
- 7" I. CEDAR DOUBLE BLAZED AND SCRIBED "Y4X BT"  
BEARS N52°E, 50.3 FT

Sketch of Monument, Accessories, and General Area

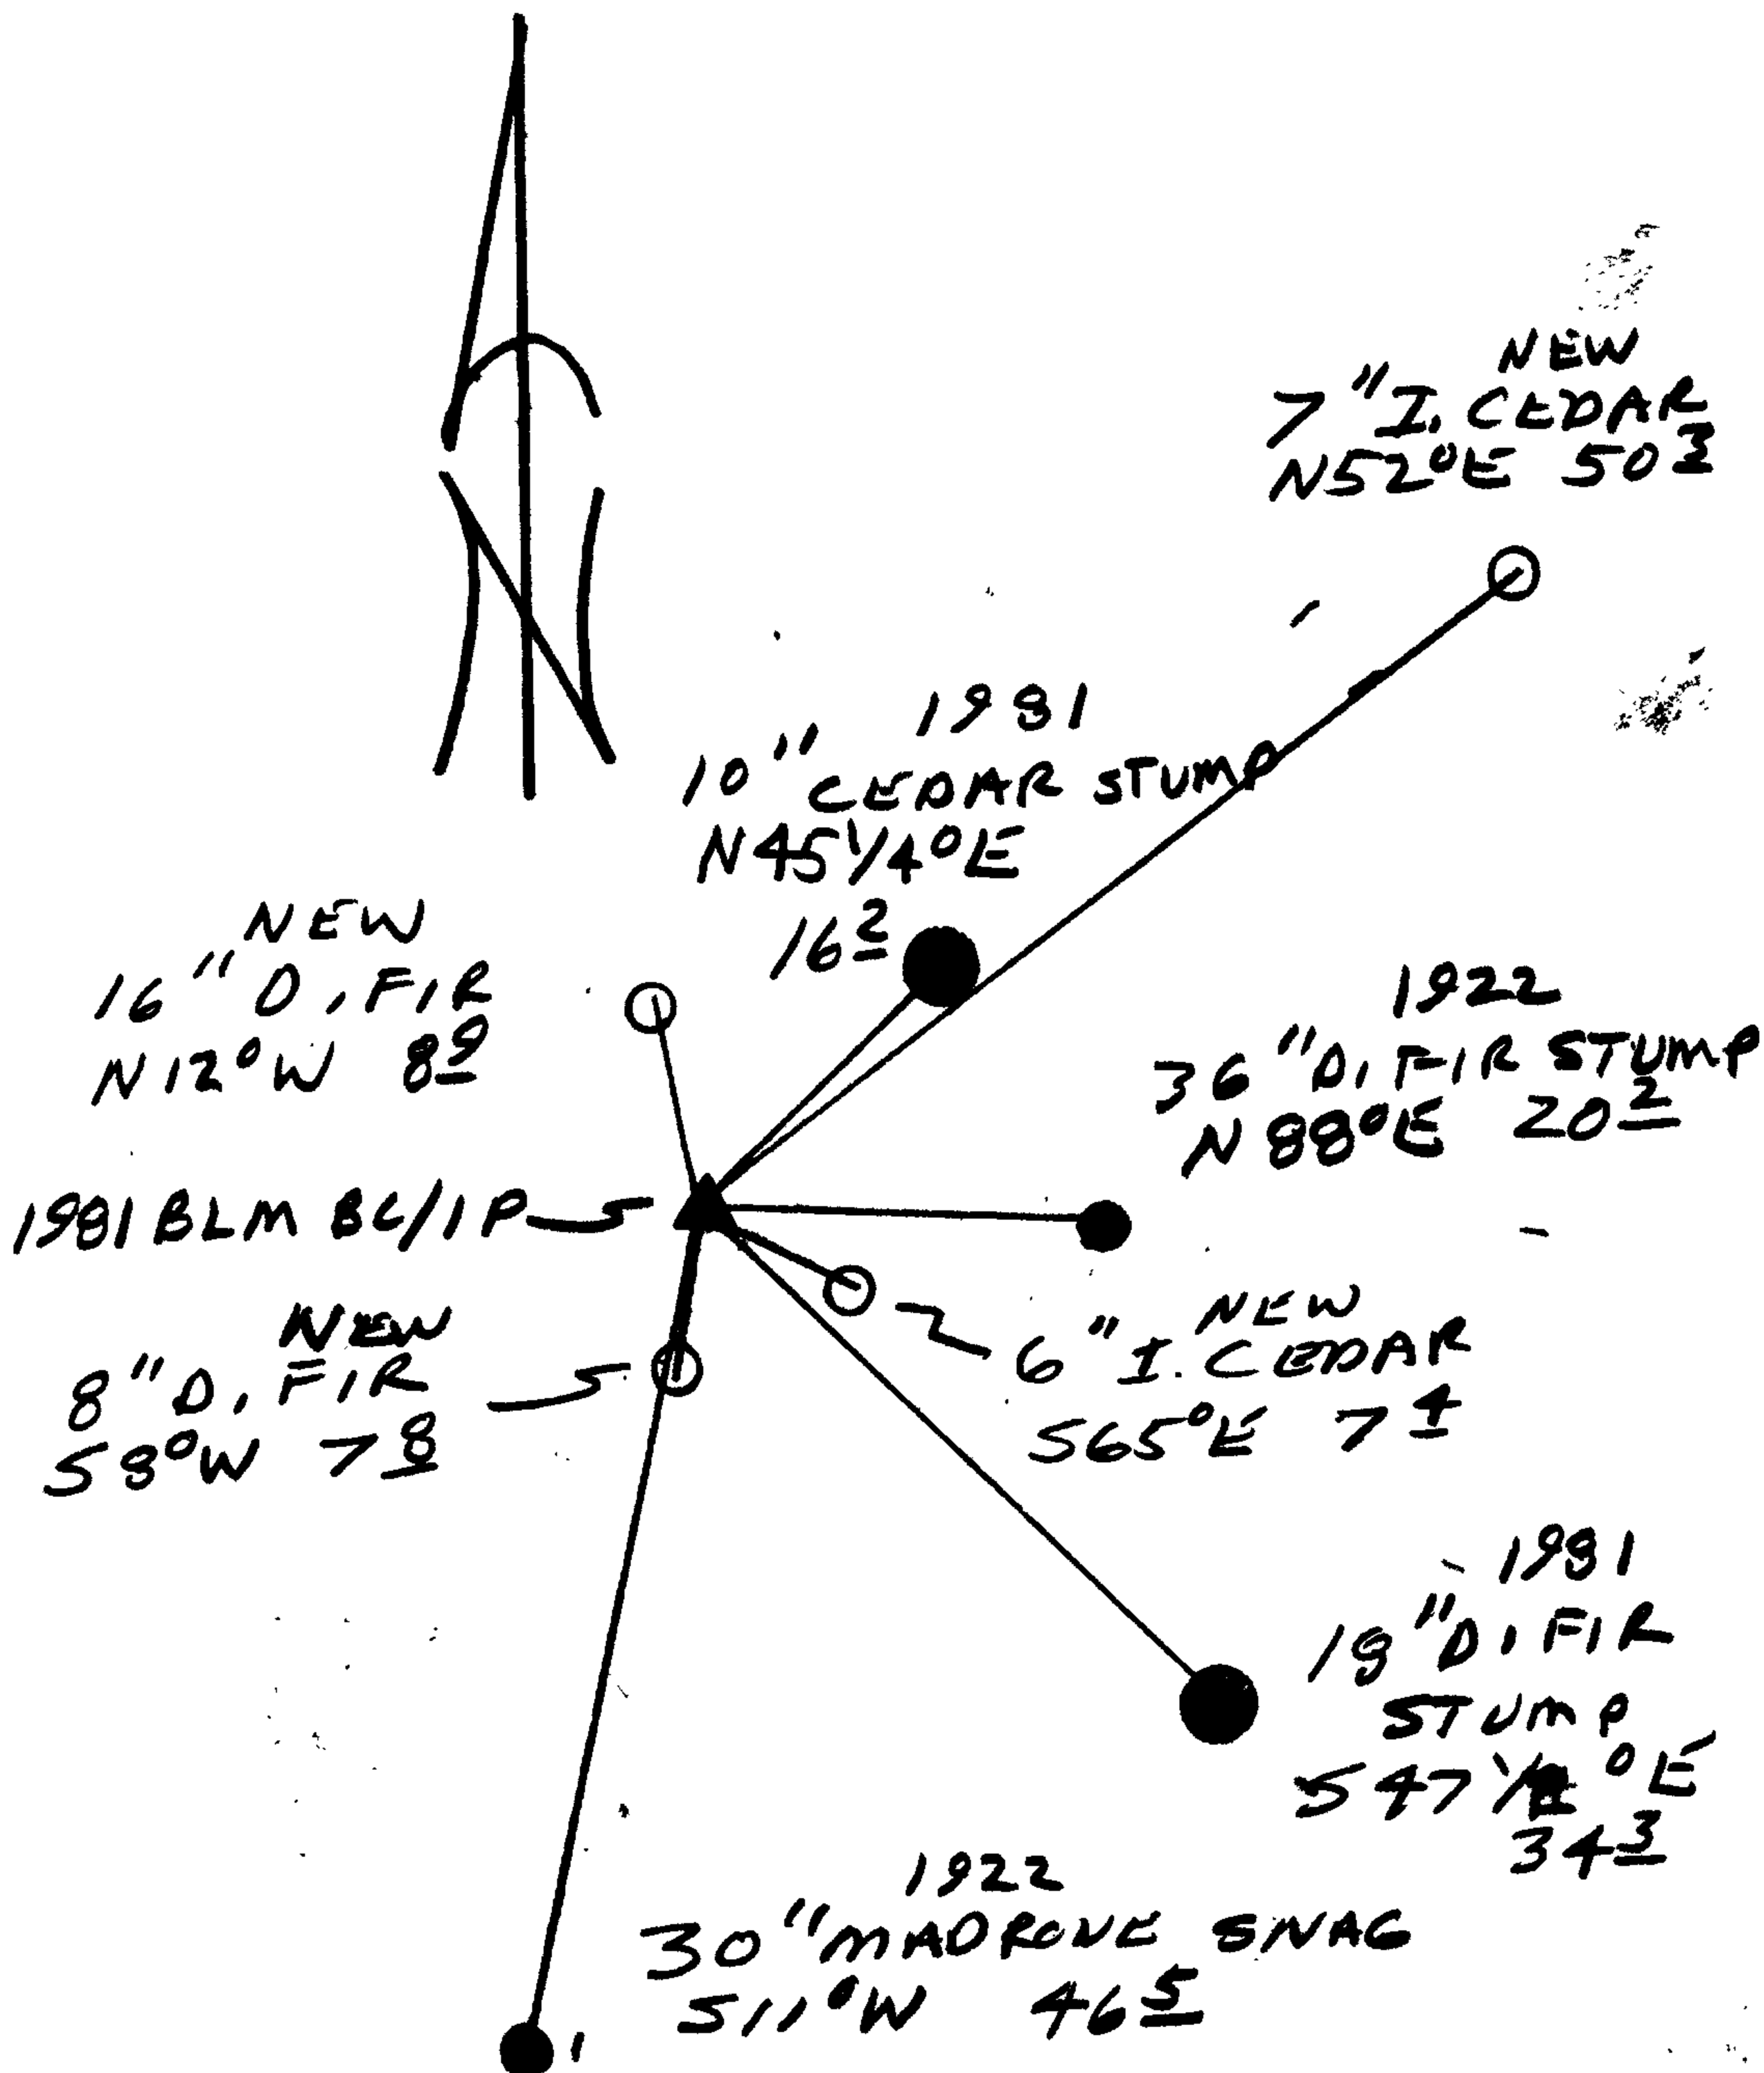

Location & Comments

Comp. Declin. 173/4°E  
 Agency DCSO  
 Party Chief RANDALL W. SMITH  
 Notekeeper [Signature]  
 Witnesses STEPHAN J. FRANK

Address

Surveyor's Seal

REGISTERED  
 PROFESSIONAL  
 LAND SURVEYOR

Randall W. Smith  
 EXPIRES 6-30-2000

OREGON  
 JULY 28, 1990  
 RANDALL W. SMITH  
 2489