

GOVERNMENT CORNER RESTORATION FORM

Date: 5-8-2000 By: JC

Township 22S Range 4W Sec. 18 County DOUGLAS Map: _____

This survey consists of: _____

State OK Date 4-25-00 No. _____

Narrative: _____

Corner Rpt: 66/14-46

Corner Designation

$\frac{1}{4} \frac{S18}{S19}$

DOUGLAS COUNTY

~~Surveyor~~ Only

- Not Found
- Renewed
- Unrecorded
- Surveyed In
- Referred Out

Previous Renewals

Monument(s) Found: (Condition and Source)

5/8" IN A NORTH - SOUTH
FENCE LINE PROBABLY
SET PER M 70-76

BRASS CAP / IRON PIPE SET
PER M 132-16

Accessories Found:

NONE

MONUMENT DETAIL

RENEWAL

Monument Set (Procedure and Description)

NONE

Monument Detail


COMMENTS: NOTE
 DISTANCE FROM NE CORNER
 OF SECTION 19 (2587.47 FT) PER
 M 133-71 TO FO 5/8" I.R. ADDED
 TO DISTANCE WITH MEASUREMENT BETWEEN
 5/8" I.R. AND BC/IP (30.5 FT)
 AGREES WELL WITH PROPORTIONED
 DISTANCES FOUND IN M 70-76
 AND M 132-16 (2617.43')

N/A

New Accessories

FROM 5/8" I.R. — 1999 BC/IP BEARS $S 88\frac{3}{4}^{\circ} W$, 30.5 FT;
 5/8" I.R. NW CORNER M 133-71 BEARS $S 21\frac{1}{2}^{\circ} E$, 116.0 FT;
 5/8" I.R. NE CORNER M 133-71 BEARS $S 52\frac{3}{4}^{\circ} E$, 178.7 FT;
 FROM BC/IP — 1979? 5/8" I.R. BEARS $N 88\frac{3}{4}^{\circ} E$, 30.5 FT;
 5/8" I.R. NW CORNER M 133-71 BEARS $S 44\frac{1}{4}^{\circ} E$, 128.8 FT;
 5/8" I.R. NE CORNER M 133-71 BEARS $S 58\frac{1}{4}^{\circ} E$, 203.6 FT.

Sketch of Monument, Accessories, and General Area

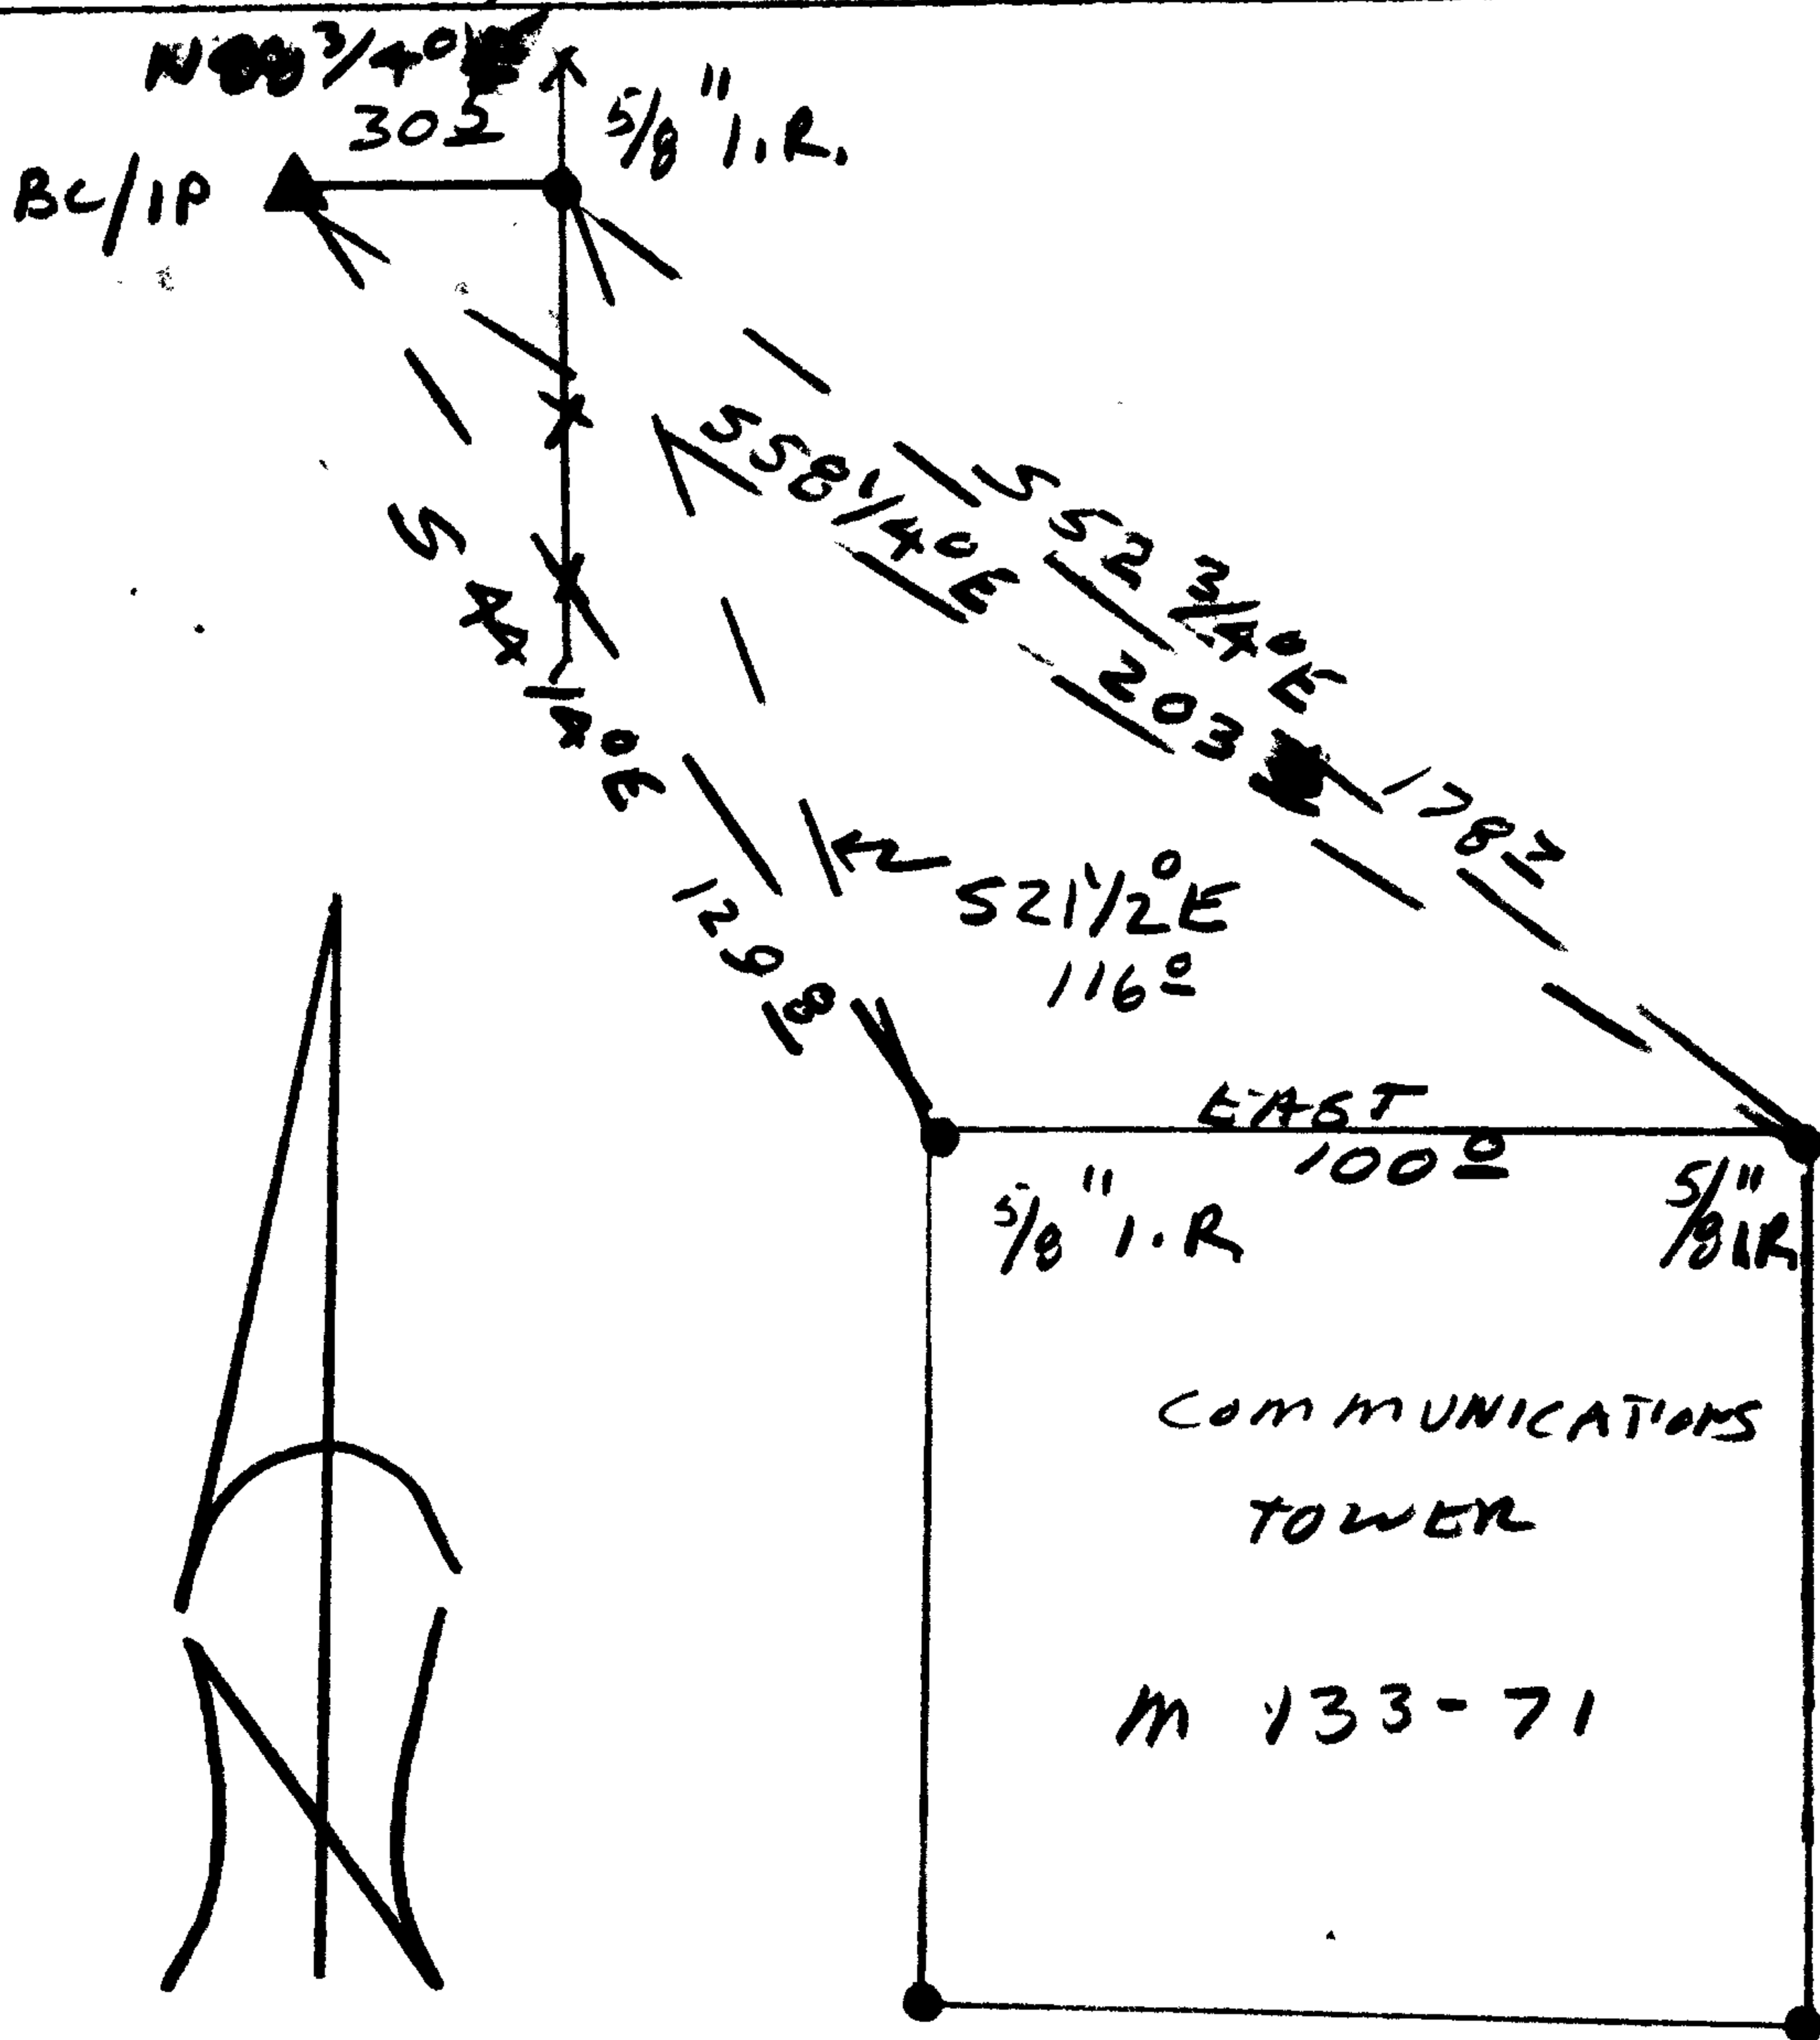

Location & Comments

SEE SURVEYS
 M 63-41
 M 70-76
 M 132-16
 M 133-71

BEARING
 Comp. Declin. N LINE M 133-71
 Agency PCSO
 Party Chief RANDALL W. SMITH
 Notekeeper [Signature]
 Witnesses STEPHEN T. FLAUSC

Address

Surveyor's Seal

REGISTERED
 PROFESSIONAL
 LAND SURVEYOR

[Signature]
 6-31-2000

OREGON
 JULY 25, 1990
 RANDALL W. SMITH
 2469