

GOVERNMENT CORNER RESTORATION FORM

Date: 6/2/00 By: SC

Township 27S Range 7W Sec. 28

County DOUGLAS This survey consists of:

State OR Date 2-10-1999 No. _____

Map: _____

Narrative: _____

Corner Rpt: CS 66/16-4

Corner Designation

INT L
COR
DLC 52

DOUGLAS COUNTY
SURVEYOR

Conductor Report Only

Not Found

Renewed

Unrecorded

Surveyed In

Referenced Out

MONUMENT DETAIL

Previous Renewals 1929 + 1938 DCSO

Monument(s) Found: (Condition and Source)

NONE

N/A

Accessories Found:

10" NOW 16" DIA. OAK WITH A PREVIOUSLY OPENED
BLAZE DOWN FALLEN IN BLAZE, BEARS
N45°W, 49.2 FT. QBT WE OPENED SCRIBING
FOUND " 52 T27S R2W"
10" NOW ROTTED D. FIR FOUND AT RECORD
" S80°E, 30.4 FT" 1929

30" NOW 32" DIA 2 1/2 FT HIGH D. FIR STUMP
WITH BARK SCRIBING VISIBLE " BT, BEARS
S20°W, 61.5 FT 1938

RENEWAL

Monument Set (Procedure and Description)

AT A POSITION DETERMINED FROM
BT'S A 5/8" BY 30" LONG
IRON ROD IS DRIVEN 12"
BELOW GROUND. 2 3/8" DIA
BRASS CAP ON A 1 3/8" O.D.
BY 32" LONG IRON PIPE
IS SET PLUMB OVER SET
IRON ROD. PROTRUDS 20"
ABOVE GROUND, SURROUND
BY A 2 1/2' DIA MOUND OF
STONE


Monument Detail

DOUGLAS COUNTY SURVEYORS
T275

DLC

R

52

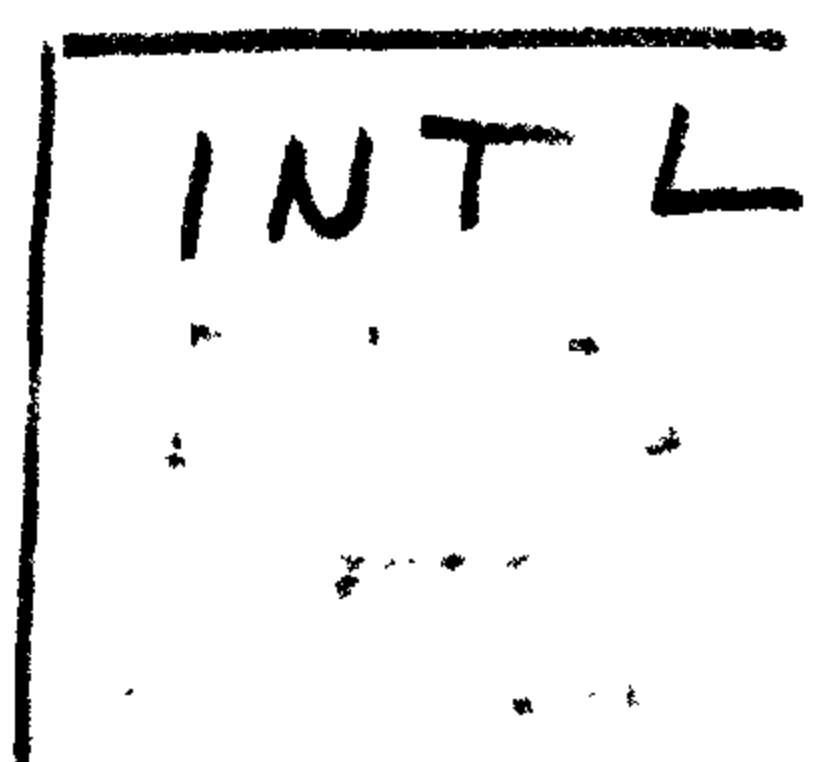

7

W

1999

OFFICE

1 3/8" DIA D. FIR DOUBLE BLAZED AND
SCRIBED "INTL DLC 52 CS BT"
BEARS S 1/6 E, 50.7 FT

New Accessories

- 7" DIA W. OAK DOUBLE BLAZED AND SCRIBED "INTL DLC 52 CS BT"
BEARS N 23 1/2° W, 12.0 FT
- 7" + " IS CRISLED IN TOP OF A 6 FT DIA BY 2 FT
(AVERAGE) HIGH SAND STONE OUTCROP,
BEARS N 3 1/4° W, 9.7 FT.
- 7" DIA W. OAK DOUBLE BLAZED AND SCRIBED "INTL DLC 52 CS BT"
BEARS N 87° E, 27.5 FT

Sketch of Monument, Accessories, and General Area

Location & Comments

CORNER LIES APPROX
25 FT NORTH OF
WESTERN, RUNNING
GULLY.

Comp. Declin. 17 3/4° E
Agency DC50
Party Chief RANDALL W. SMITH
Notekeeper
Witnesses STEPHEN J. FLAISE

Address

Surveyor's Seal

