


01-11-01 GPS R11121A
FILED JAN 25 2007

T 275 R 6 W W. SW COR SEC 18
RANDELL W SMITH STEPHEN J FLAUSG
FD 1960 DECSO BRASS CAP IRON
PIPE ALONG WEST EDGE OF DIRT
ROAD PROTRUDES 8" OUT OF GROUND

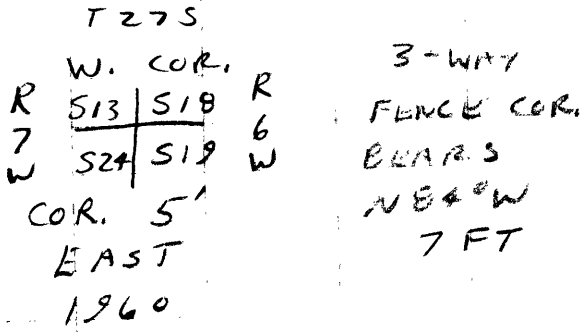

NOTE WE RENEWED THIS CORNER
IN 1993

1960 NE BT NOW GONE
1993 SE BT DOWN
1960 NW + SE BT'S FD IN
GOOD SHAPE SEE 1993 RENEWAL
NEW

11" DIA W. OAK DOUBLE BLAZED
AND SCRIBED "T 275 R 7 W 513 CS BT"
BEARS N 58 1/2° W, 58.5 FT
POWER POLE " 2-142 "
BEARS N 79 1/2° W, 28.0 FT

COMPASS OVER. 17 3/4° E
C.S. File No. 666/19-8