


# 1914 SURVEY

10-23-01

RANDALL W SMITH

(RECORD PER VOL 5 PG 20A)

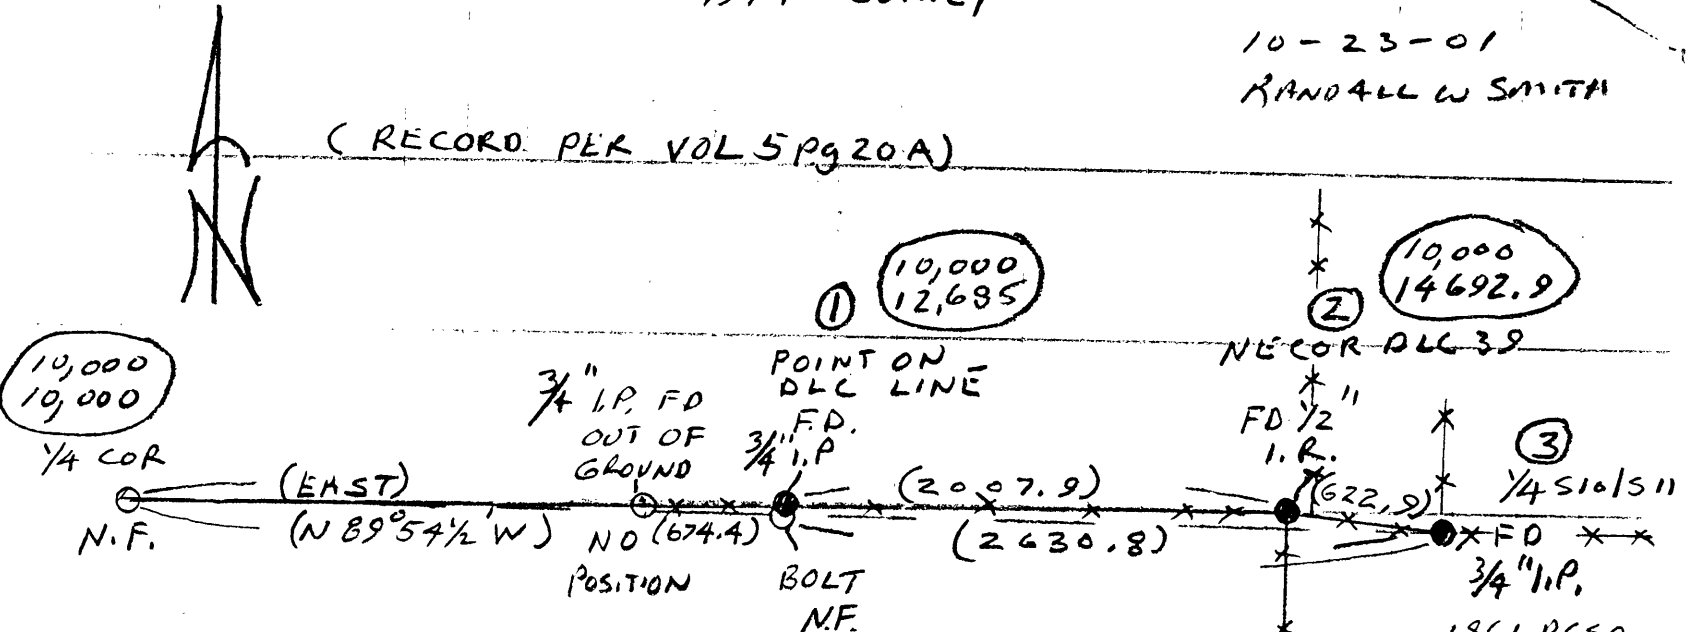

OUR MEASUREMENTS OF FOUND MONUMENTS  
BASES OF BRG EAST BETWEEN ① AND ②

- ① — ② EAST, 2008.1 (EAST, 2007.9 CALC.)
- ① — ③ N89<sup>3</sup>/<sub>4</sub>°W, 2629.6 (N89<sup>3</sup>/<sub>4</sub>°W, 2630.8 CALC.)
- ② — ③ N89°W, 621.6 (N89<sup>1</sup>/<sub>4</sub>°W, 622.9 CALC.)

C.S. File No. 06/29-18<sup>C4</sup>  
19B