

2-20-02

PI # 200240

T235 R7W Y4 S30/529

-RANDALL W SMITH, STEPHEN J FLAUSCH

FO 8" NEW 17" DIA W. OAK

WE OPEN SMALL HOLE AND

FIND GOOD SCRIBE MARK "B"

BEARS S15°W, 38.3 FT (CBT)

ORIG. NE BT GONE

SET A 2 3/8" DIA. BRASS

CAP ON A 1 3/8" BY 32" LONG IRON

PIPE AT POSITION DETERMINED

BY O.B.T. PROTRUDES 5" OUT OF

GROUND.

DOUGLAS COUNTY SURVEYORS

T235

Y4 S30/529

R7W

2002

NEW 17" DIA W. OAK DOUBLE

BLAZED AND SCRIBED "Y4S29

CS BT" BEARS S30°E, 42.8 FT

10" DIA B. OAK DOUBLE BLAZED
AND SCRIBED "Y4S29 CS BT"

BEARS N85°E, 87.5 FT

21" DIA. W. OAK DOUBLE BLAZED

AND SCRIBED "Y4S30 CS BT"

BEARS N11°W, 15.0 FT


OVER

C.S. File No. 66/32-15

FILED FEB 27 2002

No. 302

COMPASS DECL. $17\frac{1}{2}^{\circ}E$

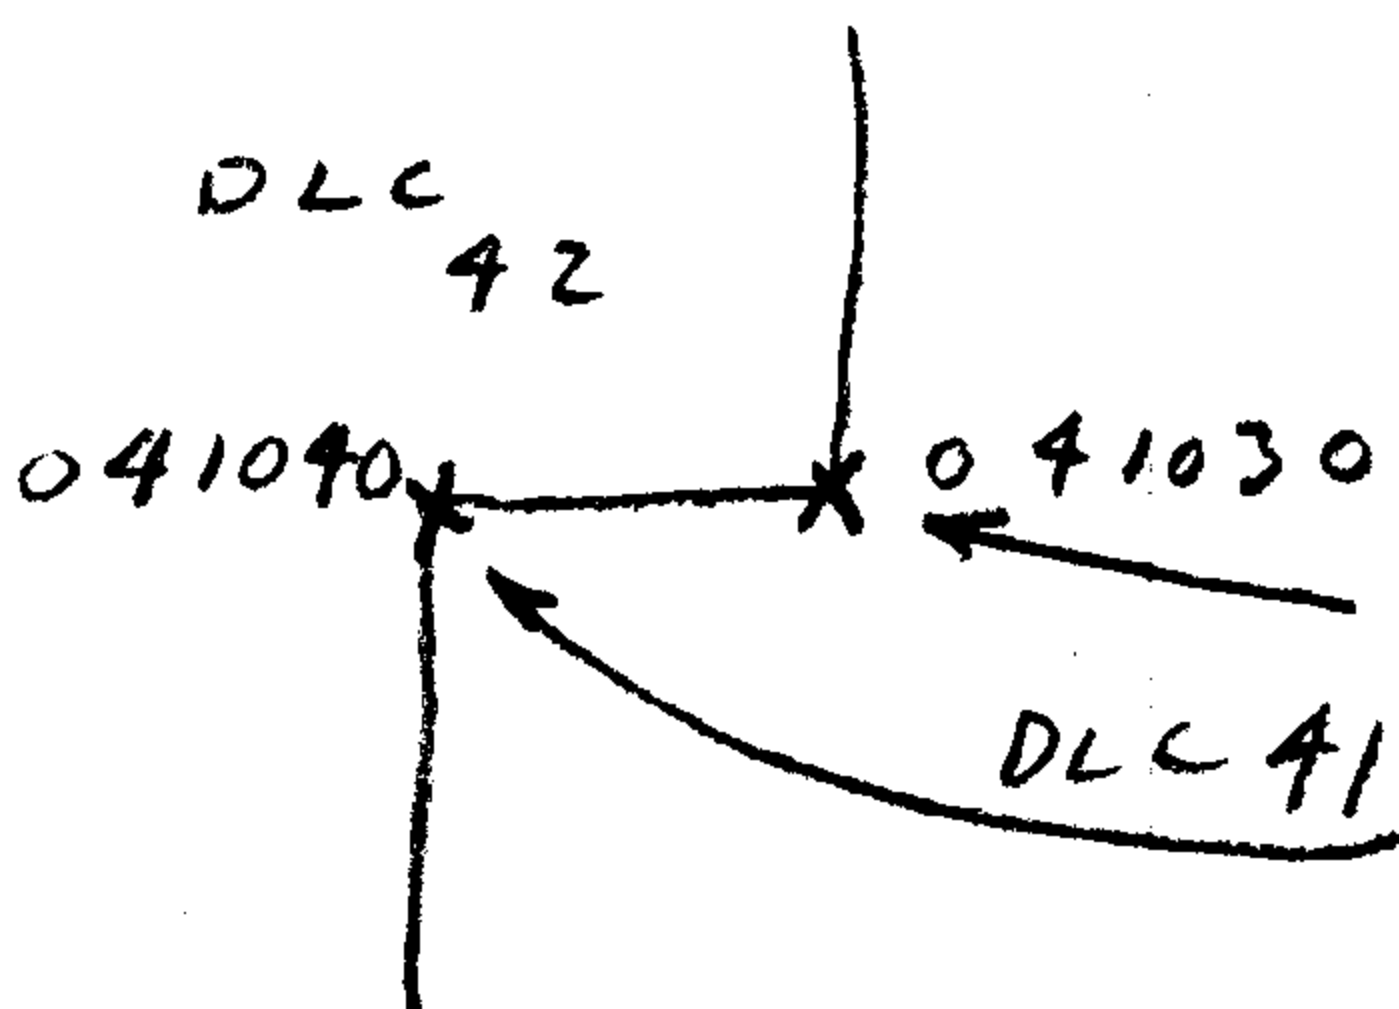

CORNERS

NOT FOUND

NOTE
FD EVIDENCE OF
SEARCH IN ONE
DOWN OAK
APPROX 100 YDS
AGO AT BOTH
CORNERS

66/32-15