

FILED JUN 26 2002


6-12-02 T265 R4W CORNER

SEARCH OF WHISTLER DLC #44

AT REQUEST OF BLM

RANDALL W SMITH STEPHEN J FLAUS

NF PI# 044010

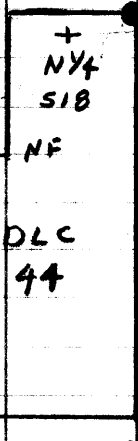

SEE CS 52/34 FOR RELATIONSHIP OF NY4 CORNER SEC 18 AND ME DLC 44 COR AS DETERMINED IN 1929 AND RENEWED IN 1999 BY PCSO

FD SOUND ?
STONE
PILE

WE OPENED NUMEROUS TREES AT THE SE, SW + NW CORNERS OF DLC 44 NO EVIDENCE OF ORIGINAL TREES FOUND. MANY TREES OPENED HAVE RING COUNTS THAT AGO WELL AS DAT'S. (NOTE NO TREES OPENED NEAR BOAT RAMP AND CAMP GROUND AT APPROX INTERIOR COR. POSITION)

(ON BACK)

CS File 66/34-7

J. L. DARLING CORP.
TACOMA WASH. 98404

"Rite in the Rain"
WEATHERPROOF

No. 302

C

CS 52/34 SHEET #6 SHOWS
INVERSE BETWEEN 9" W.O. AND
1/4 COR. AS BEING S 75° 17' W
596.51 FT

9.43 CH | 2.18 CH ORIG.
DLC RECORD
S 76° 59' W 638.8 FT

THE DIFFERENCES NOTED
ABOVE ARE SUCH THAT
OUR CORNER SEARCH PLATS
WOULD OVERLAP