


1-9-03 FILED TLED JK00P1 #056030

T27S R6W SW COR DLC #56

RANDALL W SMITH STEPHEN J FLAUSCH

A PREVIOUSLY UNINDEXED FIELD BOOK # 4* WAS *NEW 129

LOCATED. A STUDY OF CORNERS IN THIS FIELD BOOK INDICATE THAT THE 1894 2" IRON BAR WAS AT THE SW COR OF DCC #56 IN 1914. (NOTE THE 1894 RENEWAL SET THE CORNER FROM AN ORIG. BT AND MARKED A NEW BT) USING RENEWAL RECORDS A SPECIFIC AREA WAS DETERMINED.

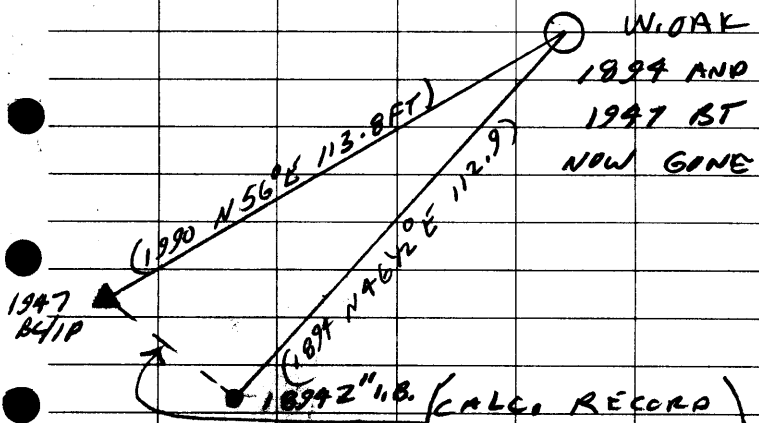

WE FOUND 1 3/4" (CALC. RECORD) 54 1/2° E 18 8 FT

IRON BAR 4" BELOW GROUND

66/58-2

AT 54 2 1/2° E 17 IF C.S. File No

COMPASS DECL. $17\frac{1}{2}^{\circ}E$

NOTE FOUND IRON BAIL
LINES UP CLOSELY WITH
THE Q OF UNPOOH ST.
SEE 1914 FB # PG 55

NO ORBIT'S FOUND

* NOW FB 129

CS 66/58-2

CS 66/58-2

W.OAK
1894
1947 BT
NOW GONE

