

GOVERNMENT CORNER RESTORATION FORM

FILED

Date: 4/8/2004 By: SC

Township 30 S Range 5W Sec. 13 County DOUGLAS

This survey consists of:

State OREGON Date MARCH 2, 2004 No. 600400

Man: \_\_\_\_\_

Name: \_\_\_\_\_

Corner Rpt: 67/6-8

Corner Designation \_\_\_\_\_

DOUGLAS COUNTY

Condition: SURVEYOR Only

Not Found \_\_\_\_\_

Renewed

Unrecorded \_\_\_\_\_

Surveyed In \_\_\_\_\_

Referenced Out \_\_\_\_\_

MONUMENT DETAIL

Previous Renewals FREAK 1918, BYRON 1958, BYRON 1963

Monument(s) Found: (Condition and Source)

FROM 1958 BYRON RENEWAL A 2 1/2 IN. DIAM. BRASS CAP (MARKED AS AT RIGHT) ON A 1 IN. I.D. IRON PIPE FIRMLY SET AND PROTRUDING 10 INS. ABOVE GROUND. B.C. MONUMENT IS ≈ 6 FT. NORTH OF FENCE LINE RUNNING WEST AND SOUTHEAST.

ALSO FOUND FROM 1918 FREAK RENEWAL A 1/2 IN. X 2 IN. IRON BAR FIRMLY SET ≈ 3 INS. BELOW GROUND. BAR LEANS ≈ 4 INS. EASTERLY FROM PLUMB. PLUMB POSITION BEARS N35°E, 20 FT DIST. FROM THE FOUND BRASS CAP (1963 RENEWAL RECORD N45°E, 2.0 FT)

COUNTY SURVEYORS OFFICE

514 | 513

523 | 524

T30S R5W  
1958

Accessories Found:

ALL ACCESSORY BANDS FROM FOUND B.C.

AN ORIGINAL 20" DIA. B. OAK NOW ROTTEN TO GROUND OAK STUMP FRAGMENTS BEAR ≈ S25°W, 6+ FT. DISTANT. NO EVIDENCE OF OTHER ORIGINAL B.T.'S FOUND.

FROM 1958 BYRON RENEWAL, EVIDENCE OF FALLEN MOSTLY BURIED 20+ IN. DIAM. D. FIR MOVED BY CAT WORK OUT OF ORIGINAL POSITION BUT NEAR THE CALL FOR A S.E. B.T. NO OTHER 1958 B.T.'S FOUND

FROM 1963 RENEWAL, THE ONE NEW B.T. IS FOUND. A 12 IN. LAUREL NOW A 17 IN. D.B.H. MARRONE WITH A FULLY HEALED DOUBLE BLAZE BEARS S22°E, 46 3/4 FT. DISTANT (RECORD S22°E, 47.3 FT, THIS IS A SLOPE DISTANCE)

C.S. File No 67/6-8

C 030218A

RENEWAL

Monument Set (Procedure and Description)

Monument Detail

~~NO ADEQUATE EVIDENCE REMAINING TO PROVE WHETHER B.S. OR IRON BAR BEST REPRESENTS ORIGINAL CORNER LOCATION.~~

*Smith*  
4/9/04


New Accessories (MEASURED FROM FOUND B.C. POSITION)

A 7 IN. D.B.H. MADRONE SCRIBED T30S R5W S24 CS BT ON A DOUBLE BLAZE BEARS S 50° E, 60' FT. DIST.

A 9 IN. D.B.H. MADRONE SCRIBED T30S R5W S24 CS BT ON A DOUBLE BLAZE BEARS S 82 1/2° E, 17 1/2' FT. DIST.

AN 8 IN. D.B.H. I. CEDAR SCRIBED T30S R5W S14 CS BT ON A DOUBLE BLAZE BEARS N 43 1/2° W, 54' FT. DISTANT.

Sketch of Monument, Accessories, and General Area

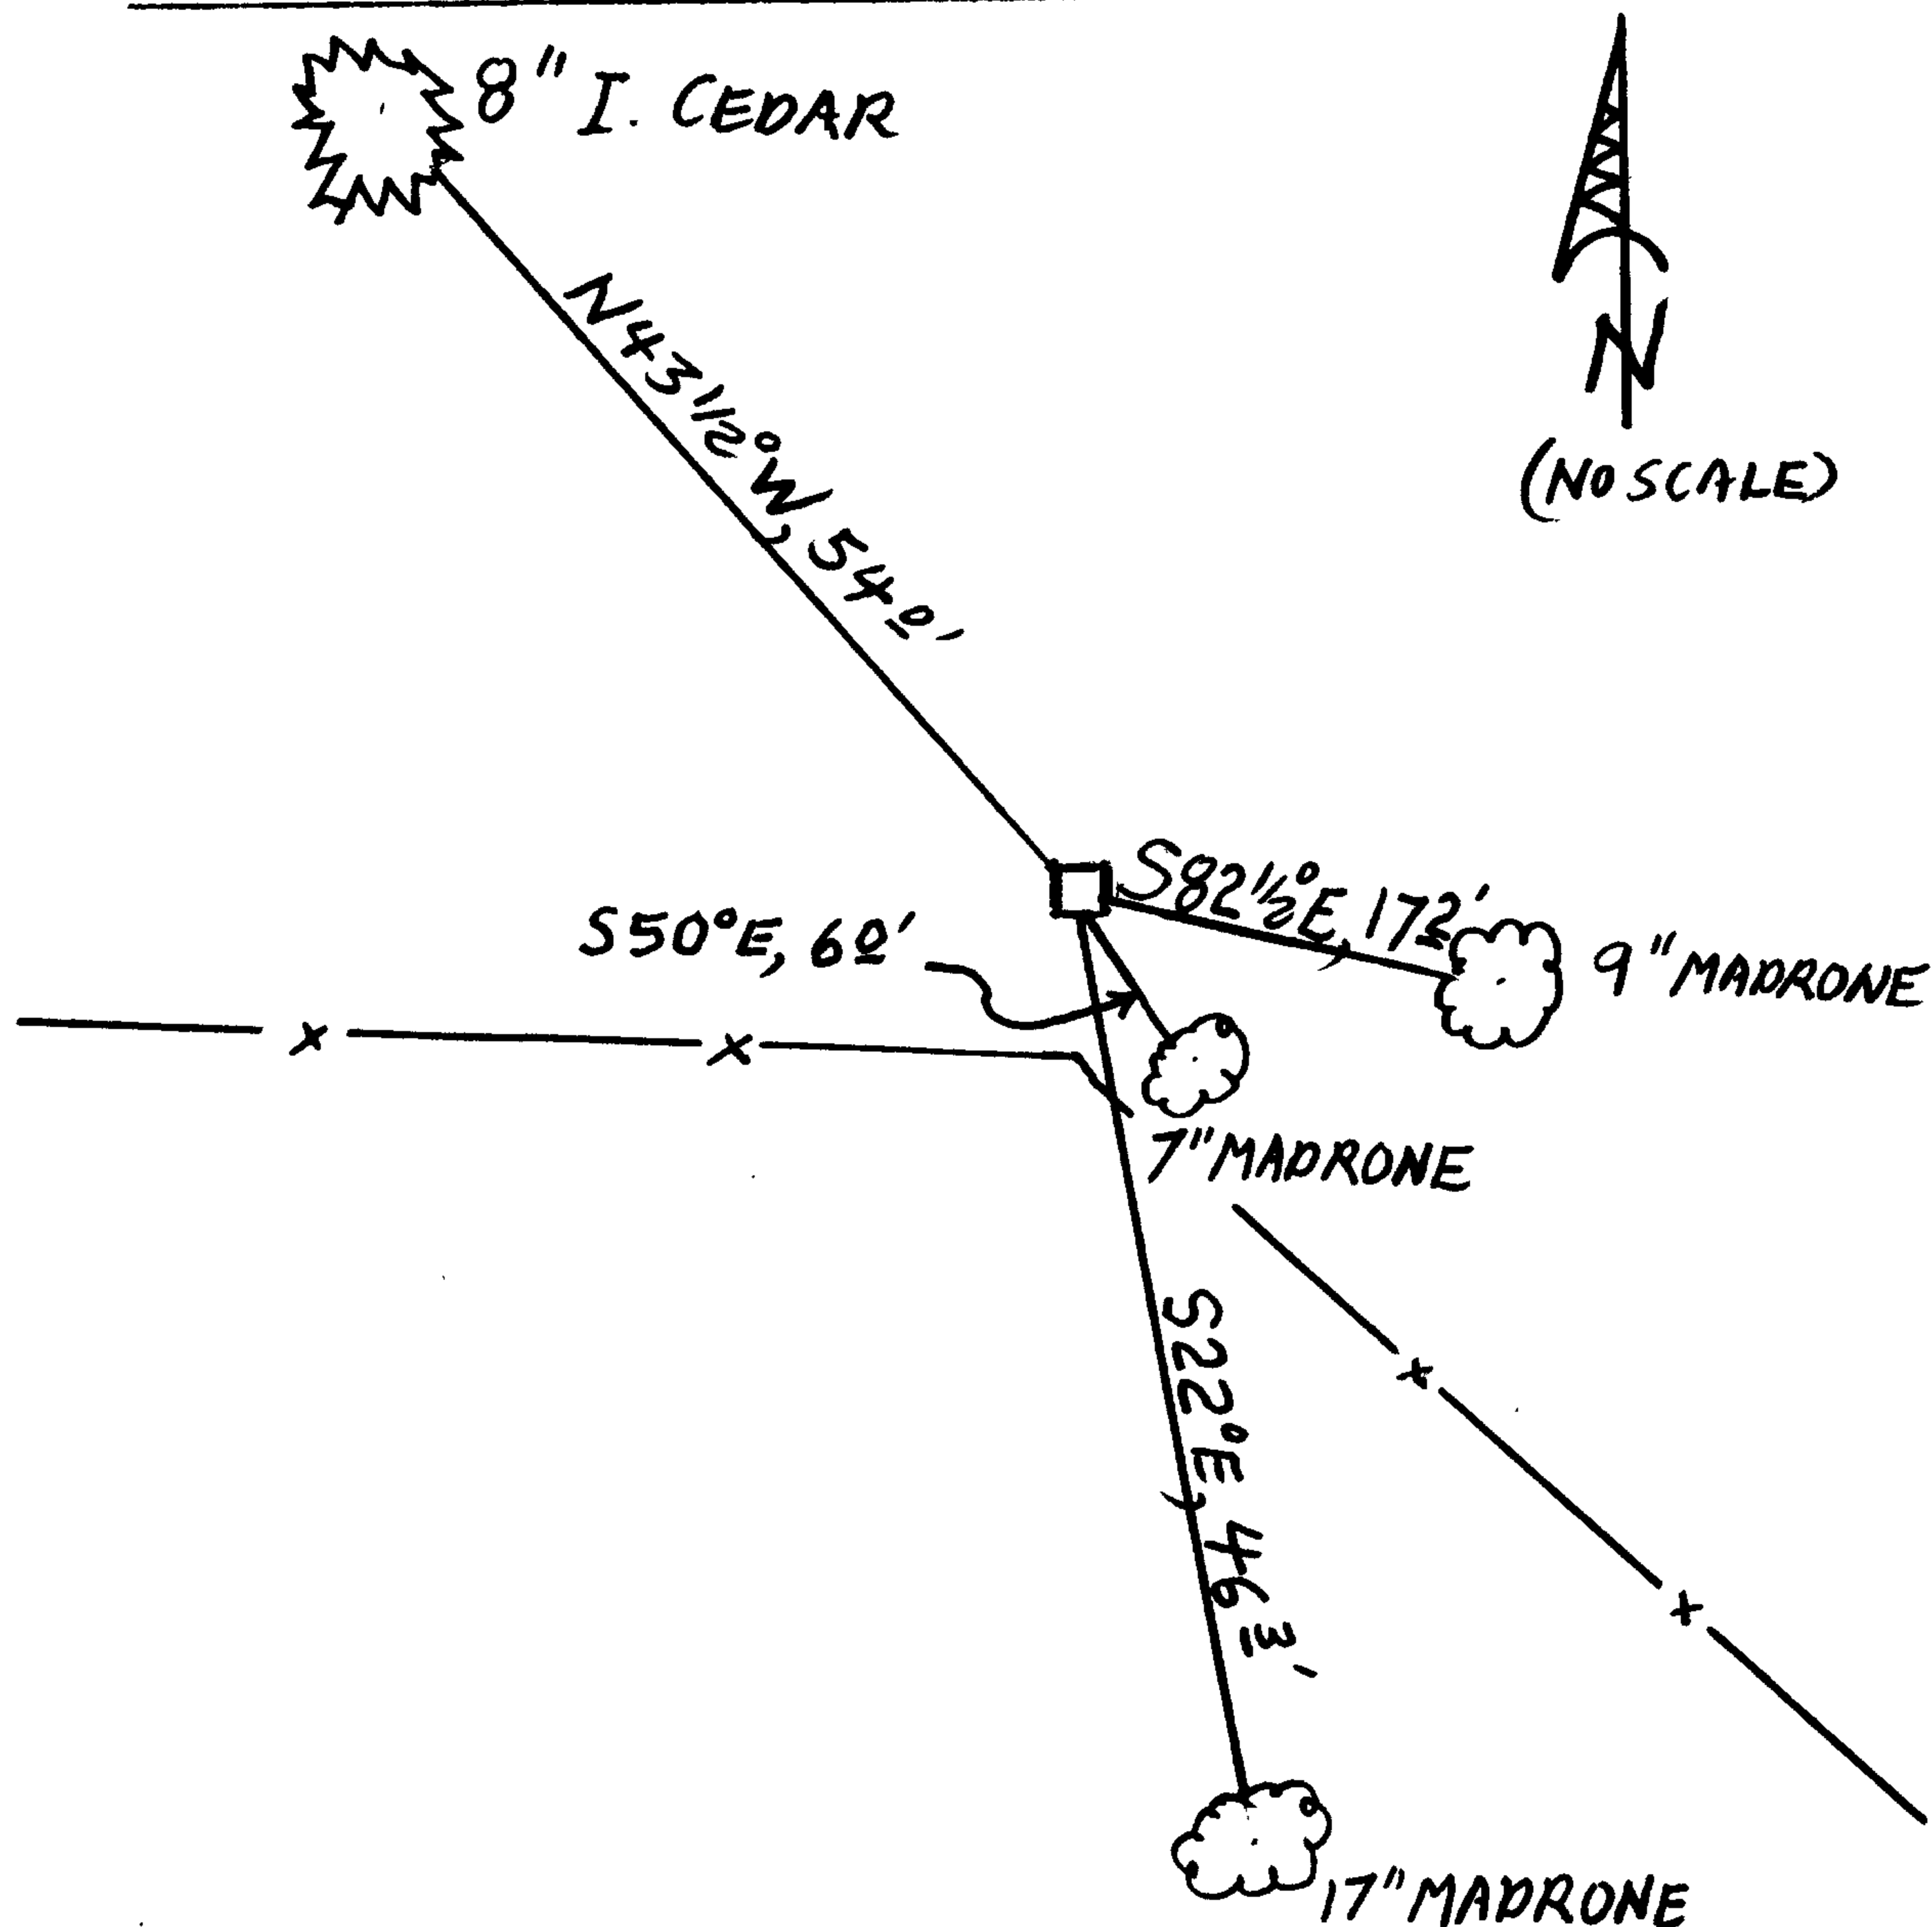

Location & Comments

MONUMENT IS ON GENTLE SE FACING SLOPE IN TREE LINE ON NORTHERLY EDGE OF LARGE PASTURE.

Comp. Declin. 16 3/4° E

Agency DCSO

Party Chief *Stephen John Flann*

Notekeeper SJF

Witnesses JOHN PIKE

Address

Surveyor's Seal

REGISTERED PROFESSIONAL LAND SURVEYOR

*Smith*  
EXPIRES 6-30-04

OREGON  
JULY 25, 1990  
RANDALL W. SMITH  
2409