


GOVERNMENT CORNER RESTORATION FORM

FILED

Township 27 Range 6 Sec. 5 County DOUGLAS Date: 4-9-2004 By: [Signature]
State OR Date 3/30/04 No. 200600 This survey consists of:
Map: _____
Narrative: _____
Corner Rep: 67/6-9

Corner Designation

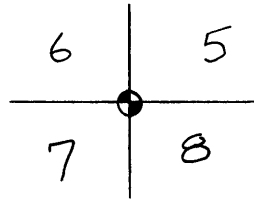


DOUGLAS COUNTY
SURVEYOR
Condition Report Only
 Not Found
 Renewed
 Unrecorded
 Surveyed In
 Referenced Out
MONUMENT DETAIL

Previous Renewals 1949 RICHARDSON/GODFREY

Monument(s) Found: (Condition and Source)

FOUND 7" X 9" STONE W/CROSS
CHISELED ON TOP, FLUSH WITH GROUND
(1949)
6 FT. STEEL FENCE POST NEXT
TO STONE.

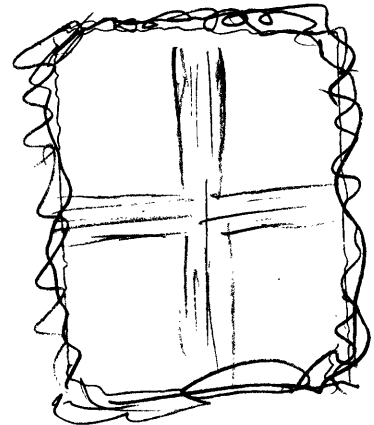

Accessories Found:

28" NOW 32" W. OAK W/FULLY HEALED SINGLE BLAZE
BEARS S 66 1/2° W 96.1 FT. (REC. 96.9 FT. SLOPE DIST. TO FACE)

36" NOW 37" W. OAK W/FULLY HEALED SINGLE BLAZE
BEARS N 53 1/2° E 206.0 FT. (TO BE CUT DOWN) (AGREES WITH REC.)

12" NOW 21" W. OAK W/FULLY HEALED SINGLE BLAZE
BEARS S 26 1/2° E 3.8 FT. (AGREES WITH REC.)

POSSIBLE ROOT DEPRESSION FOR ORIG. 30 INCH Y. OAK
BEARS S 57 3/4° W 72.6 FT

C.S. File No 67/6-9

