

GOVERNMENT CORNER RESTORATION FORM

FILED

Date: 4/9/2004 By: JC

Township 25 Range 6 Sec. 32

County DOUGLAS

This survey consists of:

State OR

Date 3/30/04

No. 041040

Narrative:

Corner Rpt: 67/6-10

Corner Designation

S.E. CORNER DLC 41

DOUGLAS COUNTY SURVEYOR

Condition Report Only

Not Found

Renewed

Unrecorded

Surveyed In

Referenced Out


MONUMENT DETAIL

Previous Renewals

Monument(s) Found: (Condition and Source)

D.C.S.O BRASS CAP IN 3 WAY FENCE CORNER.

GIS 033015 B

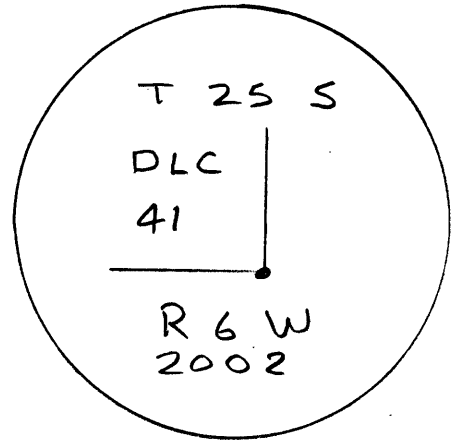

Accessories Found:

23" W. OAK BEARS S. 19° W 75.3 FT. TO BE CUT DOWN.

ALL OTHER RT'S ARE AS RECORD. (2002 D.C.S.O. RENEWAL)

