

GOVERNMENT CORNER RESTORATION FORM

Date: 9-30-2004 By: JC

Township 25 S Range 6 W Sec. 27

County DOUGLAS

This survey consists of:

State OR

Date 9-9-04

No. 057030

Map: \_\_\_\_\_  
Narrative: \_\_\_\_\_  
Corner Rpt: 67/6-22

Corner Designation

SW COR DLC 57

DOUGLAS COUNTY

SURVEYOR

Condition Report Only

Not Found

Renewed

Unrecorded

Surveyed In

Referenced Out


MONUMENT DETAIL

Previous Renewals GOODFREY, 1963

Monument(s) Found: (Condition and Source)

STONE, APPROX 5" X 17"  
PROTRUDES FROM GROUND  
11". FAINT MARKS VISIBLE  
ON STONE. HAS INDENT  
NEAR MIDDLE WHERE I TOOK  
MEASUREMENTS FROM.

STONE IS FIRMLY SET ON  
NEARLY LEVEL GROUND

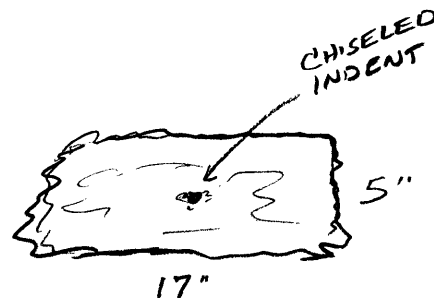

STONE

Accessories Found:

6" D. FIR NOW 23" DIA. X 36" TALL STUMP  
BEARS S 69 1/2° W, 34° FT. (1963)

29" W. OAK NOW 32" DIA. X 15" TALL PARTIALLY ROTTEN STUMP  
BEARS S 33° E 13° FT. (O.B.T.)

