

FILED

GOVERNMENT CORNER RESTORATION FORM

Date: 12-6-04 By: SC

This survey consists of:

Township 29S Range 4W Sec. 21 County DOUGLAS

State OR Date 11-10-04 No. 400343 Corner Rpt: 67/6-26

Corner Designation

CROSSING CLOSING CORNER  
FOR CLAIM 38 AND  
SECTIONS 21 & 22

DOUGLAS COUNTY  
SURVEYOR


- Condition Report Only
- Not Found
- Renewed
- Unrecorded
- Surveyed In
- Referenced Out

MONUMENT DETAIL

Previous Renewals SET BY BLM IN 1969

Monument(s) Found: (Condition and Source)

3" DIA. B.C. ON 2 1/2" I.P.  
 PROTRUDES 4" ABOVE GROUND.  
 MARKED AS SHOWN LIES 1 FT =  
 SOUTHERLY OF E-W FENCE LINE

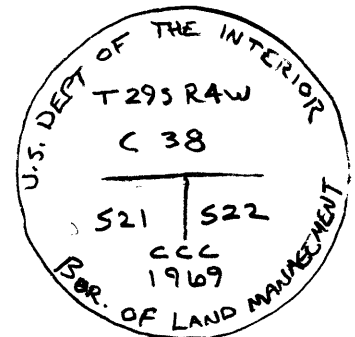

Accessories Found:

A17" NWA 21" INCENSE CEDAR, FULLY HEALED SINGLE BLAZE, TOP NOW DEAD  
BEARS S 16 1/2° E, 8 1/2 FT. AGREES W/REG. (1969 BLM)

A27" NWA 41" D. FIR, FULLY HEALED SINGLE BLAZE  
BEARS S 70 3/4° W, 82 3/4 FT. AGREES W/REG. (1969 BLM)

C.S. File No 67/6-25

