

GOVERNMENT CORNER RESTORATION FORM

Township 29 S Range 4 W Sec. 21 County DOUGLAS Date: 12-6-04 By: JC
 State OR Date 11-10-04 No. 400349
 this survey consists of:
 Map: _____
 Name: _____
 Corner Rpt: 67/6-27

Corner Designation


WITNESS COR. TO $\frac{1}{4}$ COR 21 | 22

DOUGLAS COUNTY SURVEYOR
 Condition: Only
 Not Found
 Renewed
 Unrecorded
 Surveyed In
 Referenced Out

MONUMENT DETAIL

Previous Renewals BLM 1969
 Monument(s) Found: (Condition and Source)

3" BC ON 2 1/2" I.P. PROTRUDES
 0.8' ABOVE GROUND. MARKED
 AS SHOWN. ENTIRE CAP
 ORIENTED TO SOUTH INSTEAD
 OF NORTH

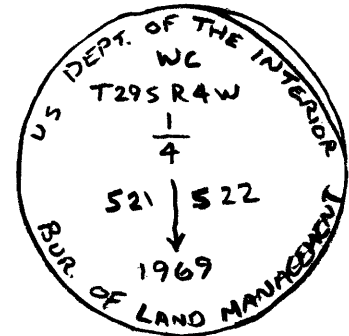

ZZ

Accessories Found:

A 15" DIA. X 37" TALL INCENSE CEDAR, HEALED BLAZE VISIBLE
 BEARS S 49 3/4° E, 29 7/8 FT. (1969 BLM) AGREES W/REC.
 A 7" DIA. X 66" TALL INCENSE CEDAR STUMP, HEALED BLAZE VISIBLE
 BEARS N 56 1/2° W, 47 7/8 FT. (1969 BLM) AGREES W/REC.

