

GOVERNMENT CORNER RESTORATION FORM

FILED

Date 12/27/2004 By [Signature]

Township 30S Range R5W Sec. 13

County DOUGLAS

This survey consists of:

State OR

Date 12/9/04


No. 700400

Map: _____

Narrative: _____

Corner Rpt: 67/6-32

Corner Designation

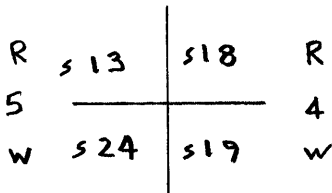

DOUGLAS COUNTY SURVEYOR

- Condition Report Only
- Not Found
- Renewed
- Unrecorded
- Surveyed In
- Referenced Out

Previous Renewals THIEL 1889; MARKHAM 1953; OCSO 1963

MONUMENT DETAIL

Monument(s) Found: (Condition and Source)

1" IRON ROD UNDER A STONE
IN 3 WAY FENCE CORNER

Accessories Found:

36" OAK STUMP NOW 30" DIA. X 24" TALL DECAYING STUMP
NO MARKS VIS. W/CHOPPED OUT BLAZE
BEARS S 89° W, 121' TO CENTER (REG. DIST. POSSIBLE
FACE MEAS.) (REG S 86° W 121' FT. MARKHAM)

