

GOVERNMENT CORNER RESTORATION FORM

FILED

Date: 2-14-2005 By: JC

Township 30S Range 5W Sec. 31

County DOUGLAS

This survey consists of:

State OR

Date 2/8/05


No. 200140

Map: _____

Narrative: _____

Corner Rpt: 67/10-5

Corner Designation

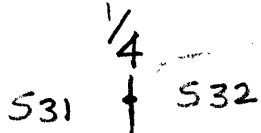

DOUGLAS COUNTY SURVEYOR

Condition: Only

Not Found

Renewed

Unrecorded

Surveyed In


Referenced Out

MONUMENT DETAIL

Previous Renewals DCSO 1979

Monument(s) Found: (Condition and Source)

2 1/2" D.C.S.O. BRASS CAP
 PROTRUDES 2" ABOVE GROUND
 ON 1 1/4" I.P. SURVEY MARKER
 NEARBY SIGN BEARS N15°W
 3 FT. ±.

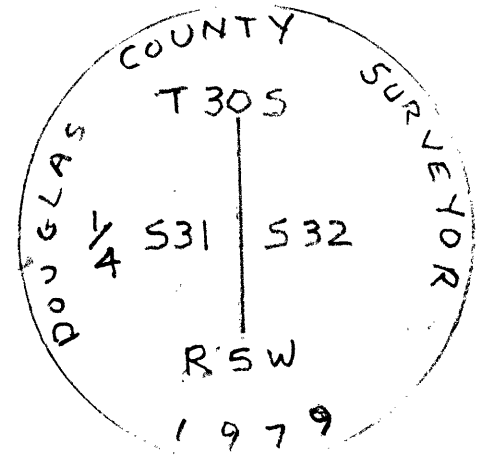

Accessories Found:

- 14" Now 27" D. FIR, HEALED BLAZE
BEARS N 76 1/4° E, 57.2 FT. AGREES W/REG. (DCSO 1979)
- 10" Now 12" W. OAK, FULLY HEALED DOUBLE BLAZE
BEARS S 34° E, 267.2 FT. AGREES W/REG. (DCSO 1979)

NOTE: THERE ARE NOW RE PLANT D. FIRS BLOCKING DIRECT LINE OF SIGHT TO W. OAK.

C.S. File No 67/10-5

