

GOVERNMENT CORNER RESTORATION FORM

Date: 3-1-2008 By: JS

Township 30 S Range 5 W Sec. 7


County DOUGLAS Map: \_\_\_\_\_

State OR Date 2-9-05

No. 100500 Narrative: \_\_\_\_\_

Corner Rpt: 67/10-6

Corner Designation

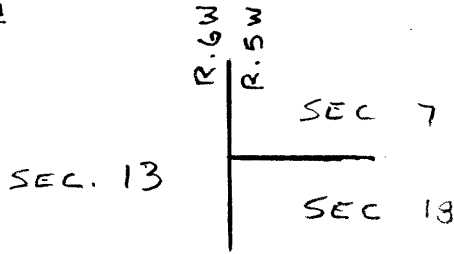

DOUGLAS COUNTY SURVEYOR


- Condition Report Only
- Not Found
- Renewed
- Unrecorded
- Surveyed In
- Referenced Out

MONUMENT DETAIL

Previous Renewals D.C.S.O., MAY 1948

Monument(s) Found: (Condition and Source)

2 1/2" BRASS CAP ON 1/4" I.P.  
BENT OVER (PLUMB POSITION  
INTACT)

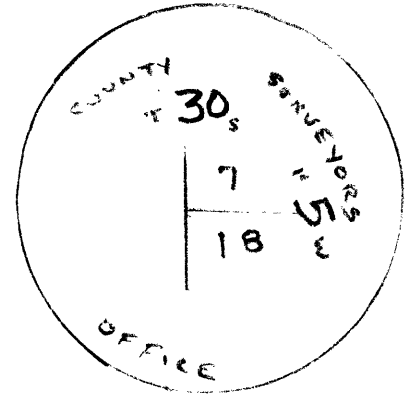

Accessories Found:

- 12" NOW 33" BULL PINE, FULLY HEALED BLAZE  
BEARS S. 57° E, 68.5 FT. (REC. S56 1/4° E, 68.5 FT)

- 28" NOW 33" BLACK OAK, BURNED UNHEALED BLAZE  
BEARS N. 26° W, 151.1 FT. (REC. DIST. MEASURES TO CENTER  
OF TRUNK AT BREAST HEIGHT, NOT CENTER OF ROOT CROWN)  
(REC. N25° W, 149.5 FT.)

