

GOVERNMENT CORNER RESTORATION FORM

FILED

Date: 3-1-2005 By: JC

Township 30 S Range 8 W Sec. 26 County DOUGLAS

This survey consists of:

State OR Date 2/24/05 No. 540200

Map \_\_\_\_\_

Name \_\_\_\_\_

Corner rpt: 67/10-8

Corner Designation \_\_\_\_\_

DOUGLAS COUNTY

Condition Surveyed

Not Found \_\_\_\_\_


Renewed

Unrecorded \_\_\_\_\_

Surveyed In \_\_\_\_\_

Referenced Out \_\_\_\_\_


MONUMENT DETAIL

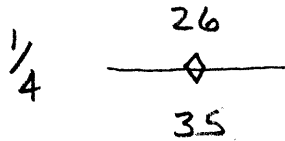

Previous Renewals H. JOHNSTONE, JUNE 1982

Monument(s) Found: (Condition and Source)

5/8" I.R. W/1/2" ALUM CAP MKO.  
" T 30 S R 8 W 1/4 26/35  
1982 LS 498" PREVIOUS  
7" OUT OF GROUND. STEEL  
FENCE POST. BEARS WEST  
2 FT.

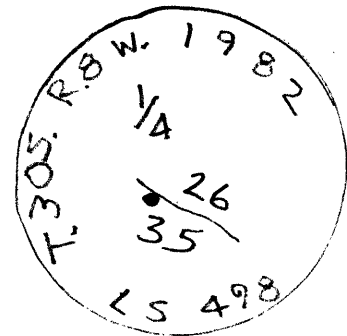

Accessories Found:

- 6" Now 12" D. FIR, HEALED SINGLE BLAZE VISIBLE, BEARS  
S 34° E, 2.8 FT. (ACROSS W/REC.)

- NE BEARING TREE NOW DOWN SHOWS FULLY HEALED BLAZE  
ROOT DEPRESSION MEASURES GOOD FOR BRG. & DIST.

C.S. File No 67/10-8

