


GOVERNMENT CORNER RESTORATION FORM

Date: 3-8-2005 By: JC

Township 30S Range 6W Sec. 12 County DOUGLAS This survey consists of:

State OR. Date 2-10-05 No. 700500 Narrative: _____

Corner Designation

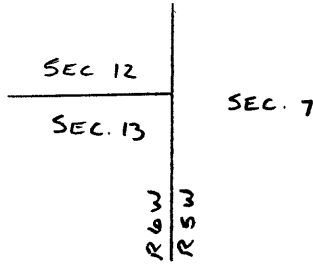

Corner Rpt: 67/10-9

DOUGLAS COUNTY

- Condition Surveyor Only
- Not Found
- Renewed
- Unrecorded
- Surveyed In
- Referenced Out

Previous Renewals B. IRVING, MAY 1929; J. BYRON OCT. 1963

MONUMENT DETAIL

Monument(s) Found: (Condition and Source)

1" I.D. IRON PIPE 15" UNDERGROUND.
5/8" I.R. ALONG SIDE LEANS
NORTHERLY 0.4 FT. AND IS APPROX.
2" UNDERGROUND.

Accessories Found:

14" MAPLE NOW SPLIT, PARTIALLY FALLEN, PARTIALLY ROTTED,
MULTI TRUNK MAPLE. REC. BRG. & DIST. TO APPARENT CENTER
OF SOUTHERLY ONCE SEPARATE GROUP OF TRUNKS.
CENTER OF ROOTCROWN BEARS N56³/₄° E, 213⁷/₈ FT.
B. IRVING REC. N57¹/₂° E 215.2 FT. (MAY 1929)

18" B. OAK NOW 16" HEALED BLAZE VISIBLE BEARS
S 2¹/₄° W, 171.3 FT. (REC. S 3° 27' W, 168.4 FT. PER M 20-23)
THIS TREE NOW ALSO WITNESSES THE SSE COR. OF DIC 37.

