

GOVERNMENT CORNER RESTORATION FORM

FILED

Date: 5/25/2005 Rv: 2

Township 26S Range 2W Sec. 7

County DOUGLAS This survey consists of:

State OR Date 5-12-05

No. 200540 Map: _____

Corner Designation

Narrative: _____
Corner Rpt: 67/10-24

1/4 7 | 8


DOUGLAS COUNTY
SURVEYOR

- Condition Only
- Not Found
- Renewed
- Unrecorded
- Surveyed In
- Referenced Out

Previous Renewals REM 1959; MENSCH 1918

Monument(s) Found: (Condition and Source)

2 1/2" DIA BC ON 1" O.D.
IRON PIPE PROJECTING
1 FT ABOVE GROUND.
LOSS IN LOW MOUNTAIN
ROCKS. B.C. IS DATED 1918

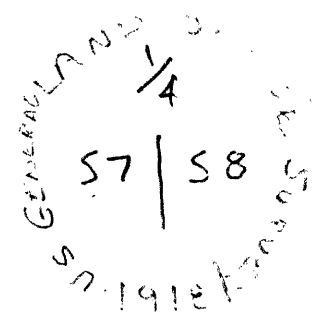

Accessories Found:

16" Now 20" D. FIR BEARS N 33 1/2° W 86 FT
(REC N 35 1/2° W, 79 FT. 1918) ORIG. BT.
FULLY HEALED SINGLE BLAZE IS FAINT

35" Now 39" D. FIR BEARS N 59 3/4° E, 92 FT
AGREES W/REC. FULLY HEALED SINGLE BLAZE VIS.
ILLEGIBLE BARK SCRIBE ALSO VISIBLE 1918 BT

A ROTTED FIR SNAG 17" DIA. APPROX 11 FT TALL
HEALED BLAZE VIS. BEARS S 72° E 6.1 FT.
(REC. S 72° E, 5.3 FT. 1918) ORIG. BT. FITS AS FACE MENS.

C.S. File No 67/10-24

