

GOVERNMENT CORNER RESTORATION FORM

FILED

Township 26 S Range 2 W Sec. 7 County DOUGLAS Date: 5/25/2005 By: JC
This survey consists of:
State OR Date MAY 17, 2005 No. 200508

Corner Designation

7 | 8
18 | 17

Corner Rpt: 67/10-25


DOUGLAS COUNTY
Condition Report Only
Not a SURVEYOR
 Renewed
 Unrecorded
 Surveyed In
 Referenced Out

Previous Renewals

MONUMENT DETAIL

Monument(s) Found: (Condition and Source)

3" BC on 2 1/2" I.P.
PROJECTS 5" ABOVE GROUND
US BLM CAP DATED 1959

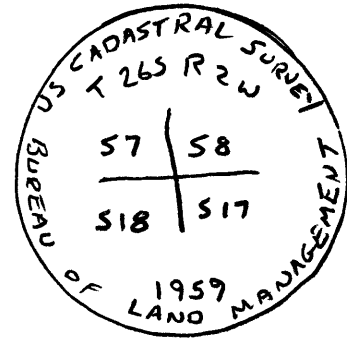

Accessories Found:

12" Now 15" HEMLOCK, PARTIALLY HEALED SINGLE BLAZE WITH
ILLEGIBLE SCRIBING, VISIBLE BEARS N 48° E, 42.6 FT.
(REC. N 51° E, 43.6 FT.)
12" Now 18" RED CEDAR, PARTIALLY HEALED SINGLE BLAZE WITH
SCRIBING "S 2W S 17 BT" VISIBLE BEARS S 54° E, 40.4 FT.
(REC. S 54° E, 40.9 FT.)
8" Now 12" HEMLOCK, NOW TIPPED ONTO ROTTED FACE, NO SCRIBING
VISIBLE, TREE IS STILL ALIVE, BEARS N 33° W, 36.3 FT. TO
ROOT HOLE

SW BEARING TREE GONE

C.S. File No 67/10-25

