

GOVERNMENT CORNER RESTORATION FORM

Township 31 S Range 9 W Sec. 4 County DOUGLAS

State OR Date 5/24/05 No. 340700

Corner Designation

$\frac{1}{4}$  5 33  
5 4

FILED  
Date 6/1/2005  
Com. 67/10-26

DOUGLAS COUNTY SURVEYOR  
Condition Report Only  
 Not Found  
 Renewed  
 Unrecorded  
 Surveyed In  
 Referenced Out


MONUMENT DETAIL

Previous Renewals BUSHEY 1893; DLCO 1965

Monument(s) Found: (Condition and Source)

BRASS CAP / IRON PIPE FOUND  
LOOSE LYING ON TOP OF GROUND

FOUND LOOSE STONE, 18" X 12" X 6"  
W/MARK "1/4" VISIBLE, ON TOP  
OF GROUND. ORIGINALLY DESCRIBED AS  
A 20 X 12 X 10 STONE, PORTIONS OF STONE  
ARE NOW BROKEN OFF.

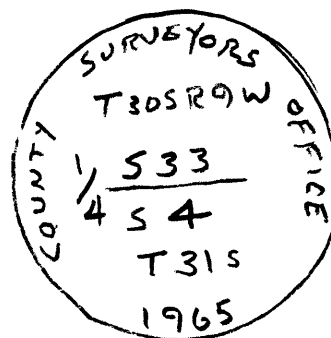

Accessories Found:

- 56" CEDAR NOW 4 FT. TALL X 48" DIA BURNT STUMP  
SCRIBING "1/4 533 6 S BT" CLEARLY VISIBLE ON PARTLY  
HEALED BLAZES BEARS N 38° E, 196 FT. (REC. N 38° E, 21.6  
AGREES WELL AS A SLOPE DIST.) 1965 BT.
- A 10" HEMLOCK NOW AN APPROX. 6" TALL X 18" DIA ROTTED STUMP NO SCRIB.  
FOUND BEARS S 79° E, 12 5/8 (1893 BT, RESCRIBED IN 1965)  
AGREES W/1965 REC.
- NW BT IS FALLEN ROTTED FIR, ROOT HOLE BEARS APPROX  
N 2 1/2° W, 14.5 FT. (AGREES W/REC) 1893 BT

RENEWAL

Monument Detail

Monument Set (Procedure and Description)

RESET BC/IP USING REG. BEARING  
 & DIST FROM HEMLOCK STUMP, AND  
 REG. BEARING & SLOPE DIST. FROM  
 BURNED CEDAR STUMP.


RESET STONE ON SOUTH EDGE OF  
 BC/IP

N/A

New Accessories

- 9" RED CEDAR, DOUBLE BLAZED & SCRIBED " 1/4 S4 CSBT"  
 BEARS S 77° E, 18.9 FT.
- 13" DIA. D. FIR, DOUBLE BLAZED & SCRIBED " 1/4 S4 CSBT"  
 BEARS S 16° E, 7.1 FT.
- 5" DIA. D. FIR, DOUBLE BLAZED & SCRIBED " X CSBT"  
 BEARS N 6° E, 6.6 FT.

Sketch of Monument, Accessories, and General Area

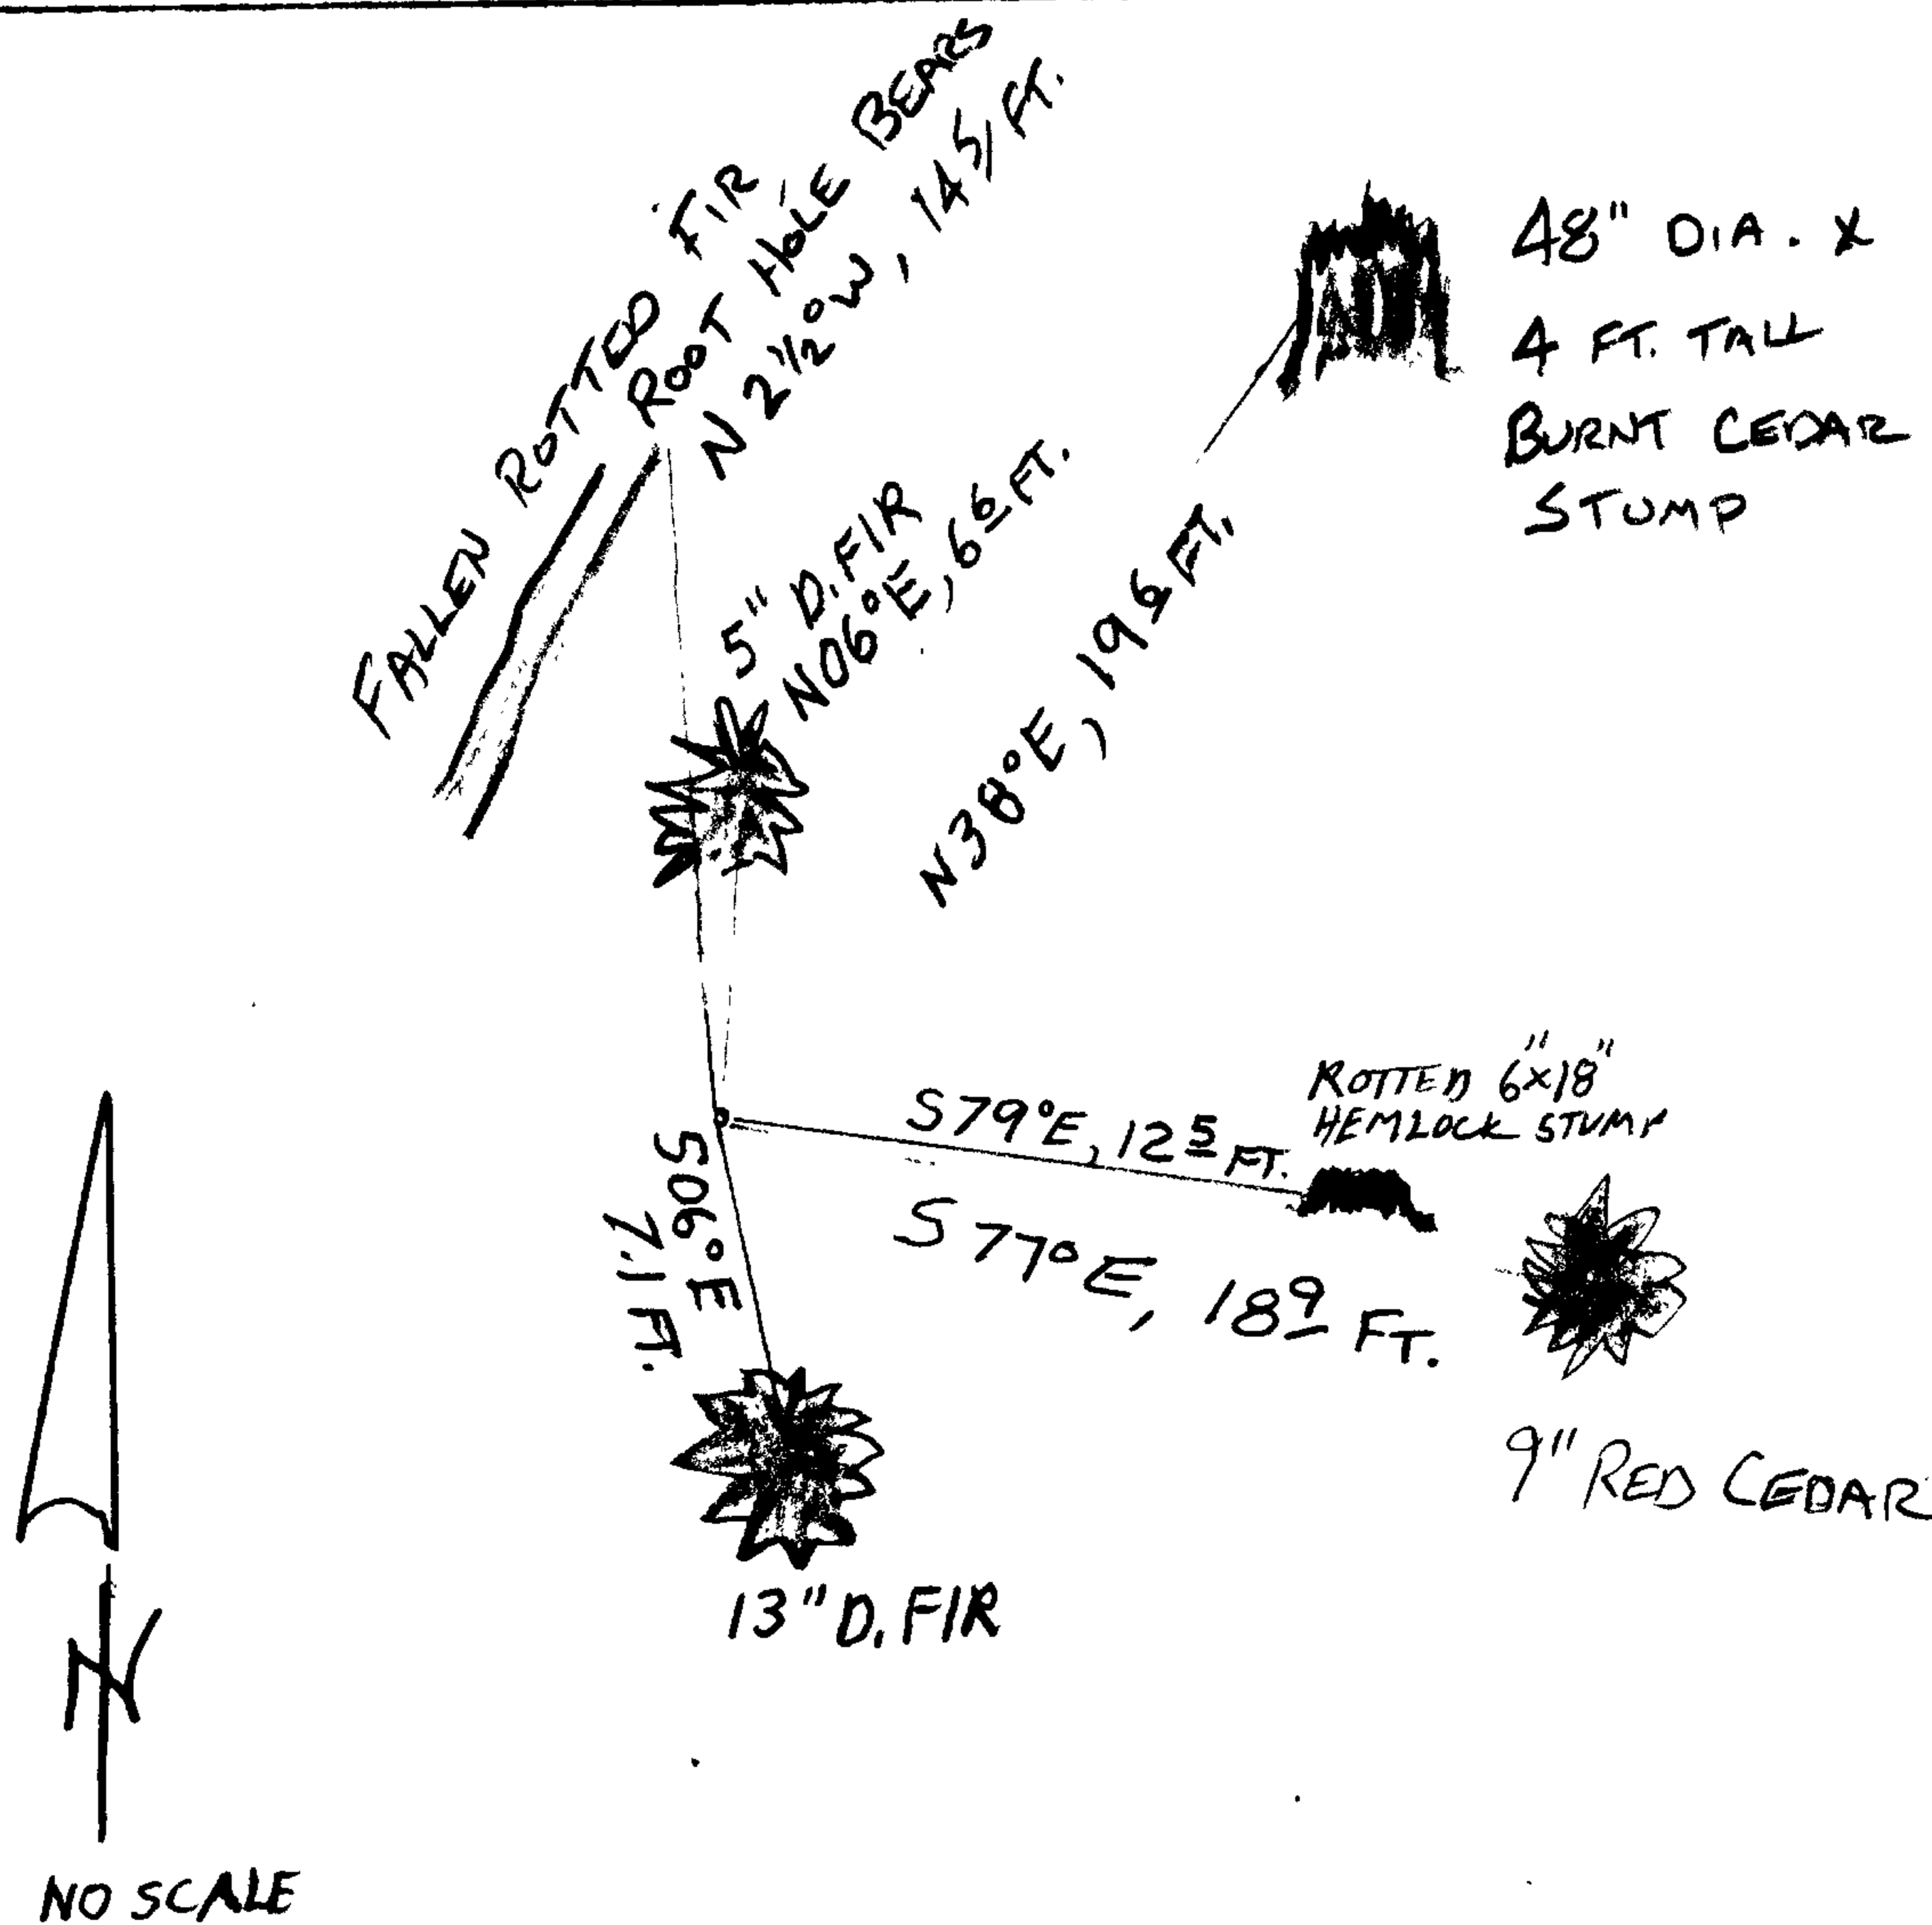

Location & Comments

CORNER LIES ON MOD. STEEP  
 SOUTH FACING SLOPE ON  
 EAST SIDE OF SMALL CREEK.

GPS SESSION C052A14A

Comp. Declin. 16 3/4° E  
 Agency DCSO  
 Party Chief S. FLAUSE  
 Notekeeper J. PIKE  
 Witnesses

Address

Surveyor's Seal

REGISTERED  
 PROFESSIONAL  
 LAND SURVEYOR

*Chadwick*  
 EXPIRES 6-30-06

OREGON  
 JULY 25, 1997  
 RANDALL W. SMITH  
 2408