

GOVERNMENT CORNER RESTORATION FORM

FILED

Date: 6-13-2005 By: JC

Township 30S Range 5W Sec. 27

County DOUGLAS This survey consists of:

State OREGON Date 6-9-2005

No. 062020 Narrative:

Corner Designation

Corner Rpt: 67/10-27

NW COR PRESTON
DLC No 62


DOUGLAS COUNTY
Condition Report Only
SURVEYOR
 Not Found
 Renewed
 Unrecorded
 Surveyed In
 Referenced Out

- Previous Renewals
- 1) G.G. STEWART, 1922
 - 2) WENDEROTH, 1951
 - 3) THOMPSON
 - 4) BAUGHMAN, 1974

MONUMENT DETAIL

Monument(s) Found: (Condition and Source)

2 1/2" DIA. BRASS CAP ON 1/4" I.P.
PROJECTS 9" ABOVE GROUND.
A 1 3/8" O.D. IRON PIPE LIES SOUTHERLY
OF BC/IP, ALMOST TOUCHING IT.
I.P. PROJECTS 8" ABOVE GROUND.
- NO PREVIOUS RECORD OF THIS B.C. -

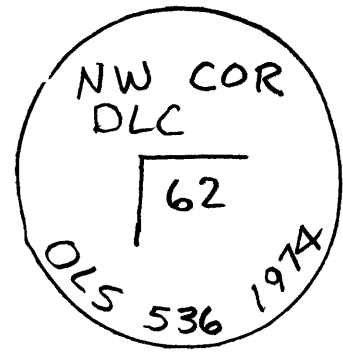

Accessories Found:

FROM BC/IP

8" OAK NOW 12" OREGON ASH, SCRIBING "NW DLC 62 BT"
VISIBLE ON PARTIALLY HEALED SINGLE BLAZE
BEARS N 8° E, 11.4 FT. (REG. N 6° E, 10.9 FT.) 1974 BT

8" OAK NOW 9" OREGON ASH, SCRIBING "NW DLC 62 BT"
VISIBLE ON PARTIALLY HEALED SINGLE BLAZE
BEARS S 80 1/2° W, 40.8 FT. TO PISTOL BUTT ROOT CROWN
(REG. S 79° W, 41.2 FT.) 1974 BT

30" W. OAK, PREVIOUSLY DOUBLE TRUNK, EVIDENCE OF
HEALED BLAZE VISIBLE BEARS S 66 1/2° W, 34.7 FT.
(REG. CALLS 14" DOUBLE W. OAK N 68° 35' W, 34.7 FT.)
WENDEROTH BT FROM 1951 - OPENED TREE AND
FOUND REVERSE SCRIBE "BT"

