

GOVERNMENT CORNER RESTORATION FORM

FILED

Date: 6/28/2005 By: X

Township 305 Range 5W Sec. 23

County DOUGLAS This survey consists of:

State OR

Date 6-16-2005

No. 052010

Map: \_\_\_\_\_

Narrative: \_\_\_\_\_

Corner Rpt: 67/10-32

Corner Designation \_\_\_\_\_

DOUGLAS COUNTY

Condition: SURVEYOR only

Not Found

Renewed

Unrecorded

Surveyed In

Referenced Out


NNE CORNER FOLLETON  
DLC No 52

Previous Renewals IRVING 1923

MONUMENT DETAIL

Monument(s) Found: (Condition and Source)

3/4" DIA. IRON ROD WITH  
OFFSET " FOOT" ON TOP.  
IRON ROD IS 1" BELOW  
GROUND LEVEL. ROD SITS  
AMONG PILE OF LARGE  
STONES

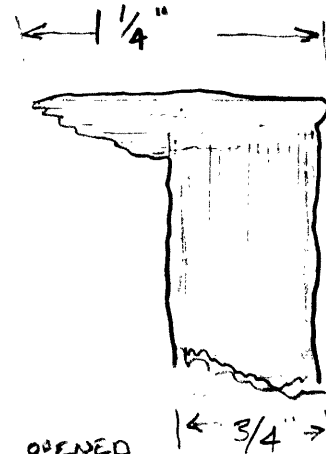

Accessories Found:

PREVIOUSLY OPENED

16" LAUREL NOW 32" DIA. MADRONE, ROTTED/BURNED FACE VISIBLE  
BEARS S 50° W, 15 2/3 FT. (ROTTED/BURNED FACE FITS WELL  
WITH IRVING'S RECORD. (REC. S 47° W, 14 2/3 FT.) 1923  
(REC. S 44° W, 13 2/3 FT.) ORIG. B.T.

ROOT HOLE WITH OAK REMAINS BEARS N 33 1/2° E, 38 2/3 FT.  
(AGREES WITH RECORD) 1923 BT

C.S. File No 67/10-32

