

FILED

GOVERNMENT CORNER RESTORATION FORM

Date: 6/28/2005 By: X

Township 30 S Range 5 W Sec. 23

County DOUGLAS

This survey consists of:

State OR

Date 6-21-2005

No. 053020

Map:

Narrative:

Corner Rpt: 67/10-33

Corner Designation

NW COR. JACKSON DLC NO 53

DOUGLAS COUNTY

Condition: SURVEYOR Only

Not Found

Renewed

Unrecorded

Surveyed In

Referenced Out


MONUMENT DETAIL

Previous Renewals B. IRVING, 1923

Monument(s) Found: (Condition and Source)

AUTO TRUCK SPRING (LEAF SPRING)
3/8" THICK X 2 1/2" WIDE. SPRING ARCHES
WHERE IT ENTERS GROUND. TOOK ALL MEAS.
TO NOTCH IN TOP OF LEAF.
PROJECTS FROM GROUND APPROX.
2". BEARS WEST 1.3 FT. FROM
N-S FENCELINE

NOTE: TO CHECK THE POSITION OF THIS MON.
WE USED THE NOTCH AT TOP OF LEAF
SPRING TO MEASURE TO THE 1" I.P. AT
E NE COR. DLC 52. WE FOUND THE
DIST. 65.73 FT. TO CLOSELY MATCH REC.
(1 CHAIN). THEREFORE WE ACCEPTED THE
POSITION WHERE MONUMENT COMES OUT OF
GROUND.

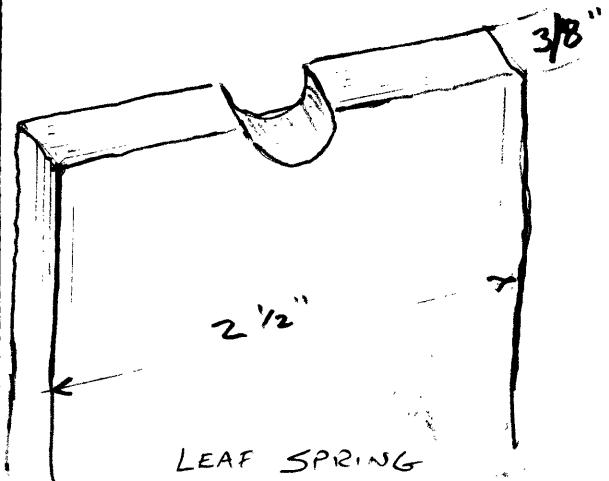

Accessories Found:

NO TRACE OF 1923 BEARING TREES FOUND

