

FOUND OK

GOVERNMENT CORNER RESTORATION FORM

FILED


Township 29S Range 4W Sec. 33 County DOUGLAS

Date: 8-16-2005 By: JC

State OR Date 4-4-05 No. 400109

Corner Designation

Corner: 67/10-38

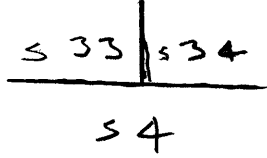


- DOUGLAS COUNTY**
- Condition Report Only
 - Not Found
 - Renewed
 - Unrecorded
 - Surveyed In
 - Referenced Out

MONUMENT DETAIL

Previous Renewals

Monument(s) Found: (Condition and Source)

3" BRASS CAP ON 2 1/2" D.I.A
PIPE PROJECTS 4" ABOVE
GROUND.

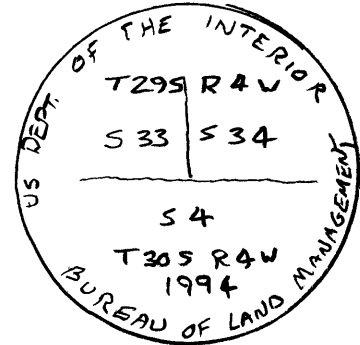

Accessories Found:

- 39" DIA. D. FIR NOW 40" X A' TALL STUMP, CHOPPED
OUT BLAZE VISIBLE.
- 11" MADRONE NOTED AS SNAG BY BLM IN 1994 IS AN
ALIVE TREE, SCRIBING STILL VISIBLE
- ALL OTHER ACCESSORIES ARE FOUND AS NOTED
IN B.L.M. 1994 REPORT

C.S. File No 67/10-38

