

FILED

Date: 8/16/2005 By: SC

This survey consists of:

GOVERNMENT CORNER RESTORATION FORM

Township 21 S Range 5W Sec. 30 County DOUGLAS

Map: \_\_\_\_\_

State OR Date 7-25-2005 No. 140200

Narrative: \_\_\_\_\_

Corner Rpt: 67/10-41

Corner Designation

DOUGLAS COUNTY SURVEYOR

$\frac{1}{4}$  COR       $\frac{S \ 30}{S \ 31}$


- \_\_\_\_\_ Condition Report Only
- \_\_\_\_\_ Not Found
- Renewed
- \_\_\_\_\_ Unrecorded
- \_\_\_\_\_ Surveyed In
- \_\_\_\_\_ Referenced Out

MONUMENT DETAIL

Previous Renewals BB1, 1939; VRT 1970

Monument(s) Found: (Condition and Source)

2 1/2" BC ON 1 1/4" O.D. IRON PIPE  
MKA. D.C.S.O. 1970 (SEE DETAIL)  
PROJECTS FROM GROUND 12".

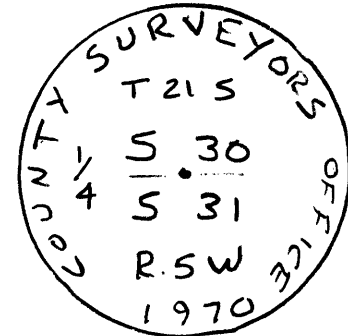

Accessories Found:

- 16" W. OAK NOW ROOT HOLE WITH DOWN & ROTTED OAK  
ALONGSIDE BEARS N 44 1/2° W 19 1/2 FT. (AGREES W/REC.)  
1939 BT
- 10" NOW 19" DIA D. FIR, HEALED BLAZE VISIBLE  
BEARS S 46° E, 3 1/2 FT. (AGREES W/REC.) 1970 BT
- 5" DIA. W. OAK, NOW PART OF MULTI TRUNK TREE, ILLEGIBLE  
SCRIBING VISIBLE ON 7" DIA DEAD TRUNK, BEARS S 72 1/2° E,  
38 3/4 FT (1970 REC = S 72 1/2° E 37 1/4 FT.) DIST 37 1/4 HTS SIDE  
CENTER OF DEAD TRUNK, 1939 BT
- 6" NOW 14" DIAM'S TALL STUMP, HEALED BLAZE VISIBLE  
BEARS N 37 1/2° E, 17 3/4 FT. (REC. N 40° E 17 1/4 FT.) 1970 BT
- HAINES T IRON NOT FOUND (REC. N 52 1/2° W 62 7/8 FT.) 1955

C.S. File No 67/10-41

