

FILED

Date: 2/24/2005 By: J

GOVERNMENT CORNER RESTORATION FORM

This survey consists of:

Township 30S Range 5W Sec. 9 County DOUGLAS
State OREGON Date MARCH 29, 2004 No. 400540 Corner Rpt: 67/10-42

Map: _____
Narrative: _____

Corner Designation

DOUGLAS COUNTY
SURVEYOR

1/4
59 | S10

- Condition Report Only
- Not Found
- Renewed
- Unrecorded
- Surveyed In
- Referenced Out

Previous Renewals DCSO 1959 & 1963, BLM 1969 & 1986

MONUMENT DETAIL

Monument(s) Found: (Condition and Source)

ORIGINAL CORNER TREE A FIR 19 INCH
DIAM. NOW A ROTTED 1 FOOT TALL 20+ INCH
DIAM. BROKEN FIR STUMP. TRUNK OF CORNER
TREE HAS FALLEN WESTERLY ON FACE.

N/A

1959 DCSO BC/IP IS MISSING.

Accessories Found: (ALL B & D'S MEASURED FROM STUMP ABOVE)

EVIDENCE OF TWO ORIGINAL B.T.'S FOUND. A LARGE UPROOT HOLE IS
FOUND NEAR B. AND D. FOR NORTHWEST B.T. A 2 1/2 FOOT TALL 32 INCH
DIAM. PARTLY ROTTED AND PREVIOUSLY OPENED FIR STUMP WITH THE SCRIBING
"BT" VISIBLE BEARS S 80° E, 8 6 FT. DISTANT (AS PER ORIGINAL RECORD
NOTED AS TREE NOT OF RECORD IN 1986 BLM RENEWAL).

FROM THE 1959 DCSO RENEWAL AN 8" R. FIR NOW AN 11 INCH D.B.H.
7 FOOT TALL ROTTED FIR SNAG WITH A FULLY HEALED DOUBLE BLAZE BEARS
N 47° E, 43 3/4 FT. DISTANT (RECORD N 46 1/2° E, 45 5/8 FT. DISTANT; MEASURED FROM
MISSING 1959 B.C.)

FROM THE 1963 DCSO RENEWAL A 14" R. FIR NOW A 16 INCH DIAMETER
1 FOOT TALL FIR STUMP WITH EVIDENCE OF A HEALED BLAZE IN THE BARK ONLY
BEARS S 44° W, 28 3/4 FT. DISTANT (RECORD S 43° W, 27 1/2 FT. DISTANT; MEASURED
FROM MISSING 1959 B.C.)

FROM THE 1969 BLM RENEWAL TWO THEN NEW B.T.'S FOUND. A FIR 11" DIAM.
NOW 12" DIAMETER FALLEN AND ROTTED FIR SNAG ROTTEN FACE NO SCRIBING BEARS S 33 1/2° E, 56 3/4 FT. (REC. S 34 3/4° E, 57 1/2 FT.)
AND A CEDAR 13" DIAM. NOW A 32 INCH D.B.H. INCENSE CEDAR WITH A FULLY HEALED
DOUBLE BLAZE BEARS N 85 1/2° W, 129 3/4 FT. DISTANT (AS PER RECORD).

FROM THE 1986 BLM RENEWAL ONE THEN NEW B.T. FOUND. A FIR 7" DIAM.
NOW A 14 INCH D.B.H. DOUGLAS FIR WITH A FULLY HEALED DOUBLE BLAZE BEARS
N 54° E, 25 1/2 FT. DISTANT (AS PER RECORD).


C.S. File No 67/10-42

RENEWAL

Monument Set (Procedure and Description)

Monument Detail

ALL B.&D.'S RECORDED IN ACCESSORIES FOUND ARE MEASURED FROM A POINT VERY NEAR THE APPROXIMATE CENTER OF THE ORIGINAL CORNER TREE STUMP. THIS POSITION IS REFERENCED OUT AND A HOLE IS DUG IN THE ROTTED STUMP REMAINS. A 2 1/2 INCH DIAMETER BRASS CAP (MARKED AS AT RIGHT) ON A 1 1/4 INCH O.D. X 31 INCH LONG GALVANIZED IRON PIPE IS FIRMLY SET PROTRUDING APPROX. 6 INCHES ABOVE GROUND LEVEL AT THE ABOVE NOTED REFERENCED POSITION.

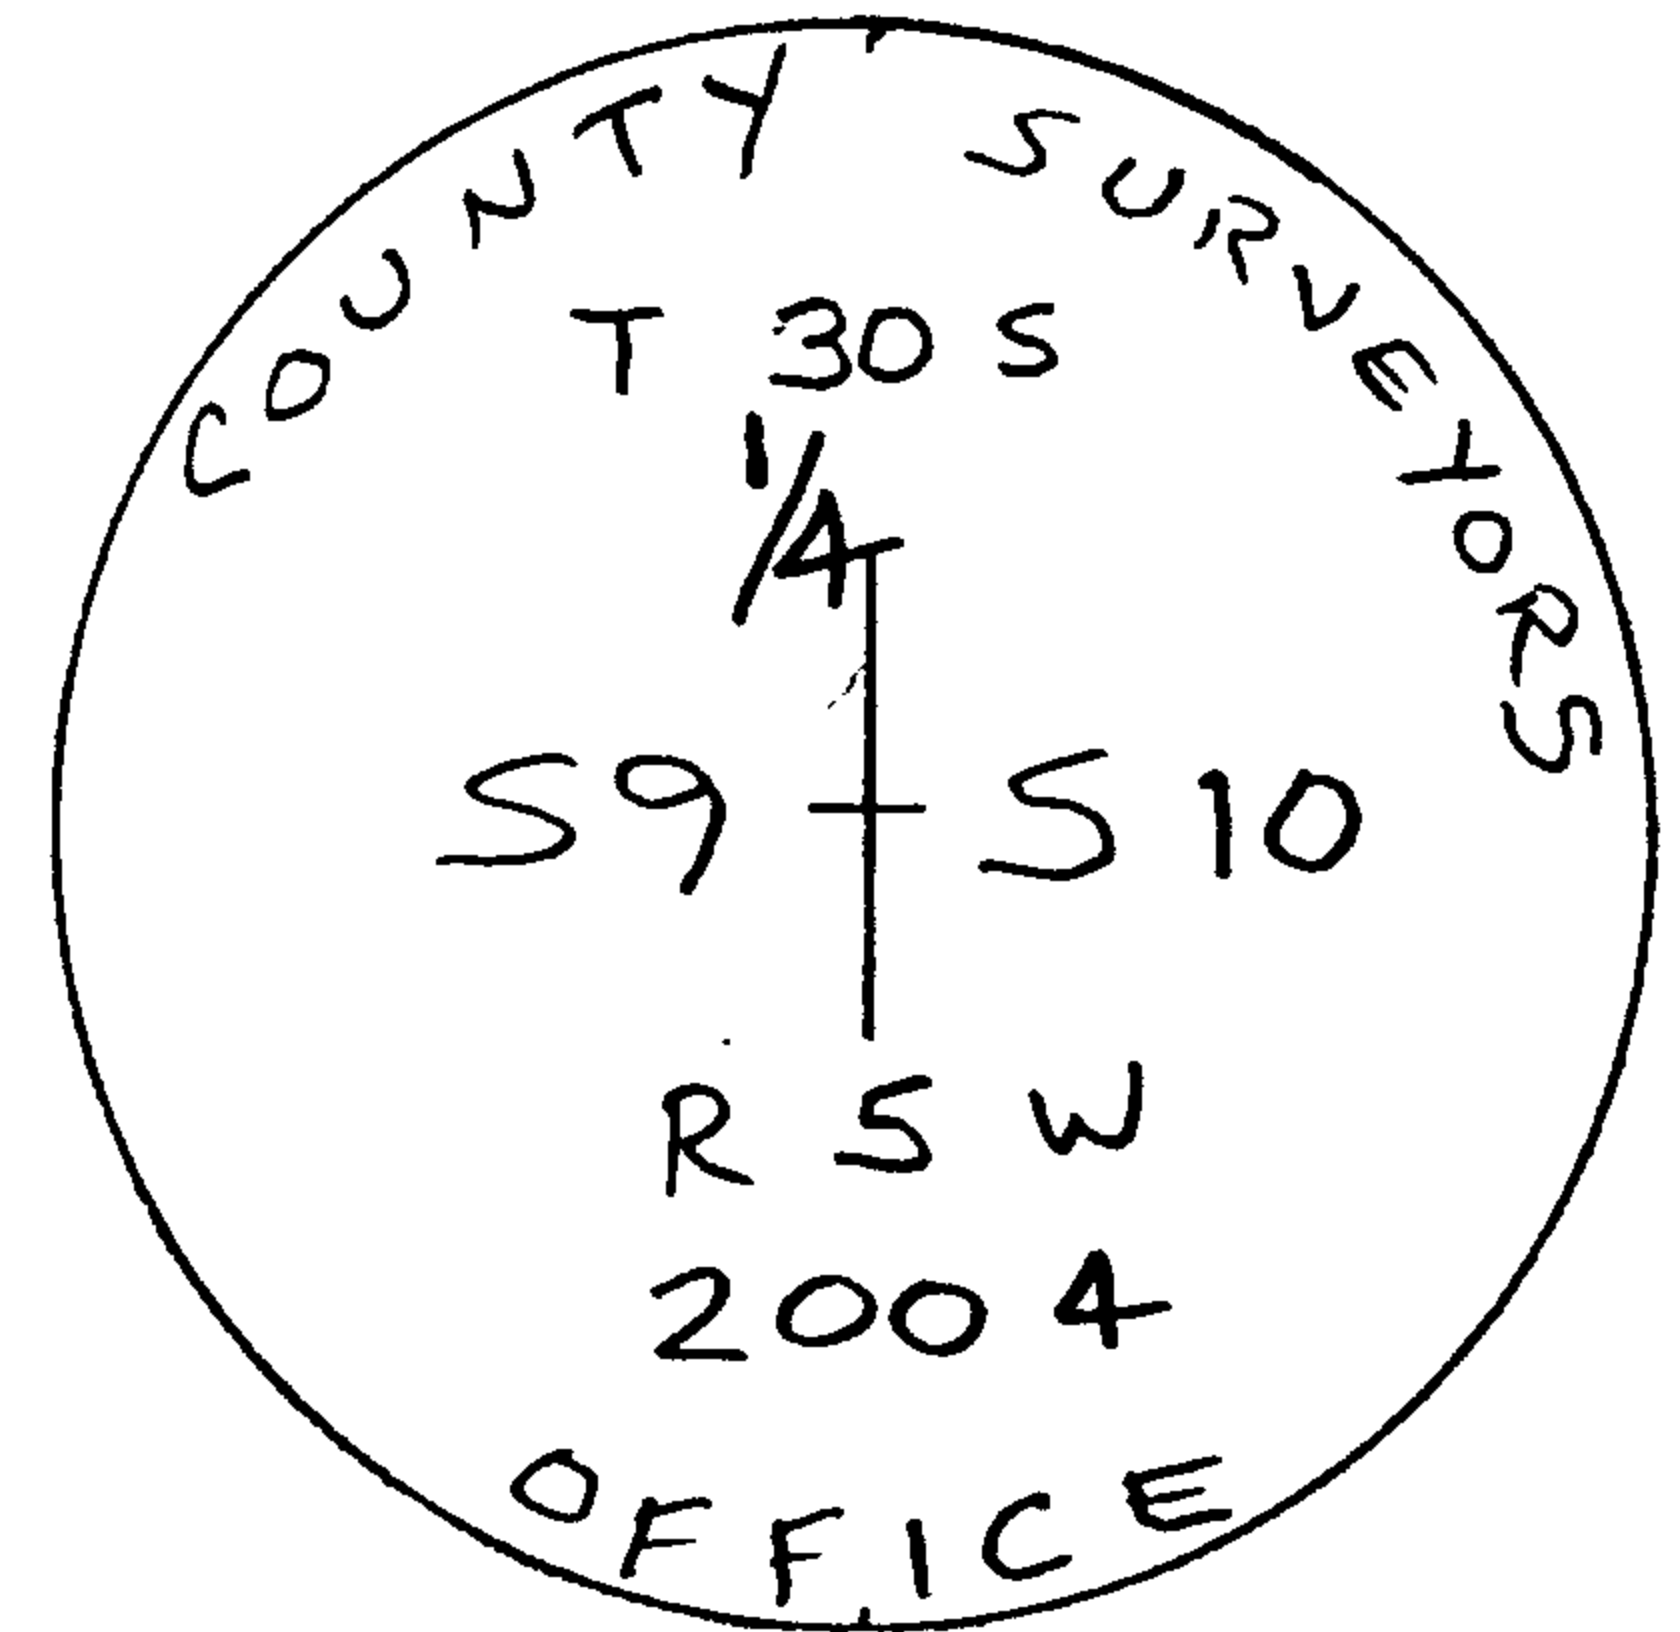


New Accessories

20" D. FIR BEARS S 58° W 26.8 FT DOUBLE BLAZED & SCRIBED " 1/4 S 9 CS BT "

16" D. FIR BEARS S 46° E 32.2 FT DOUBLE BLAZED & SCRIBED " 1/4 S 10 CS BT "

Sketch of Monument, Accessories, and General Area

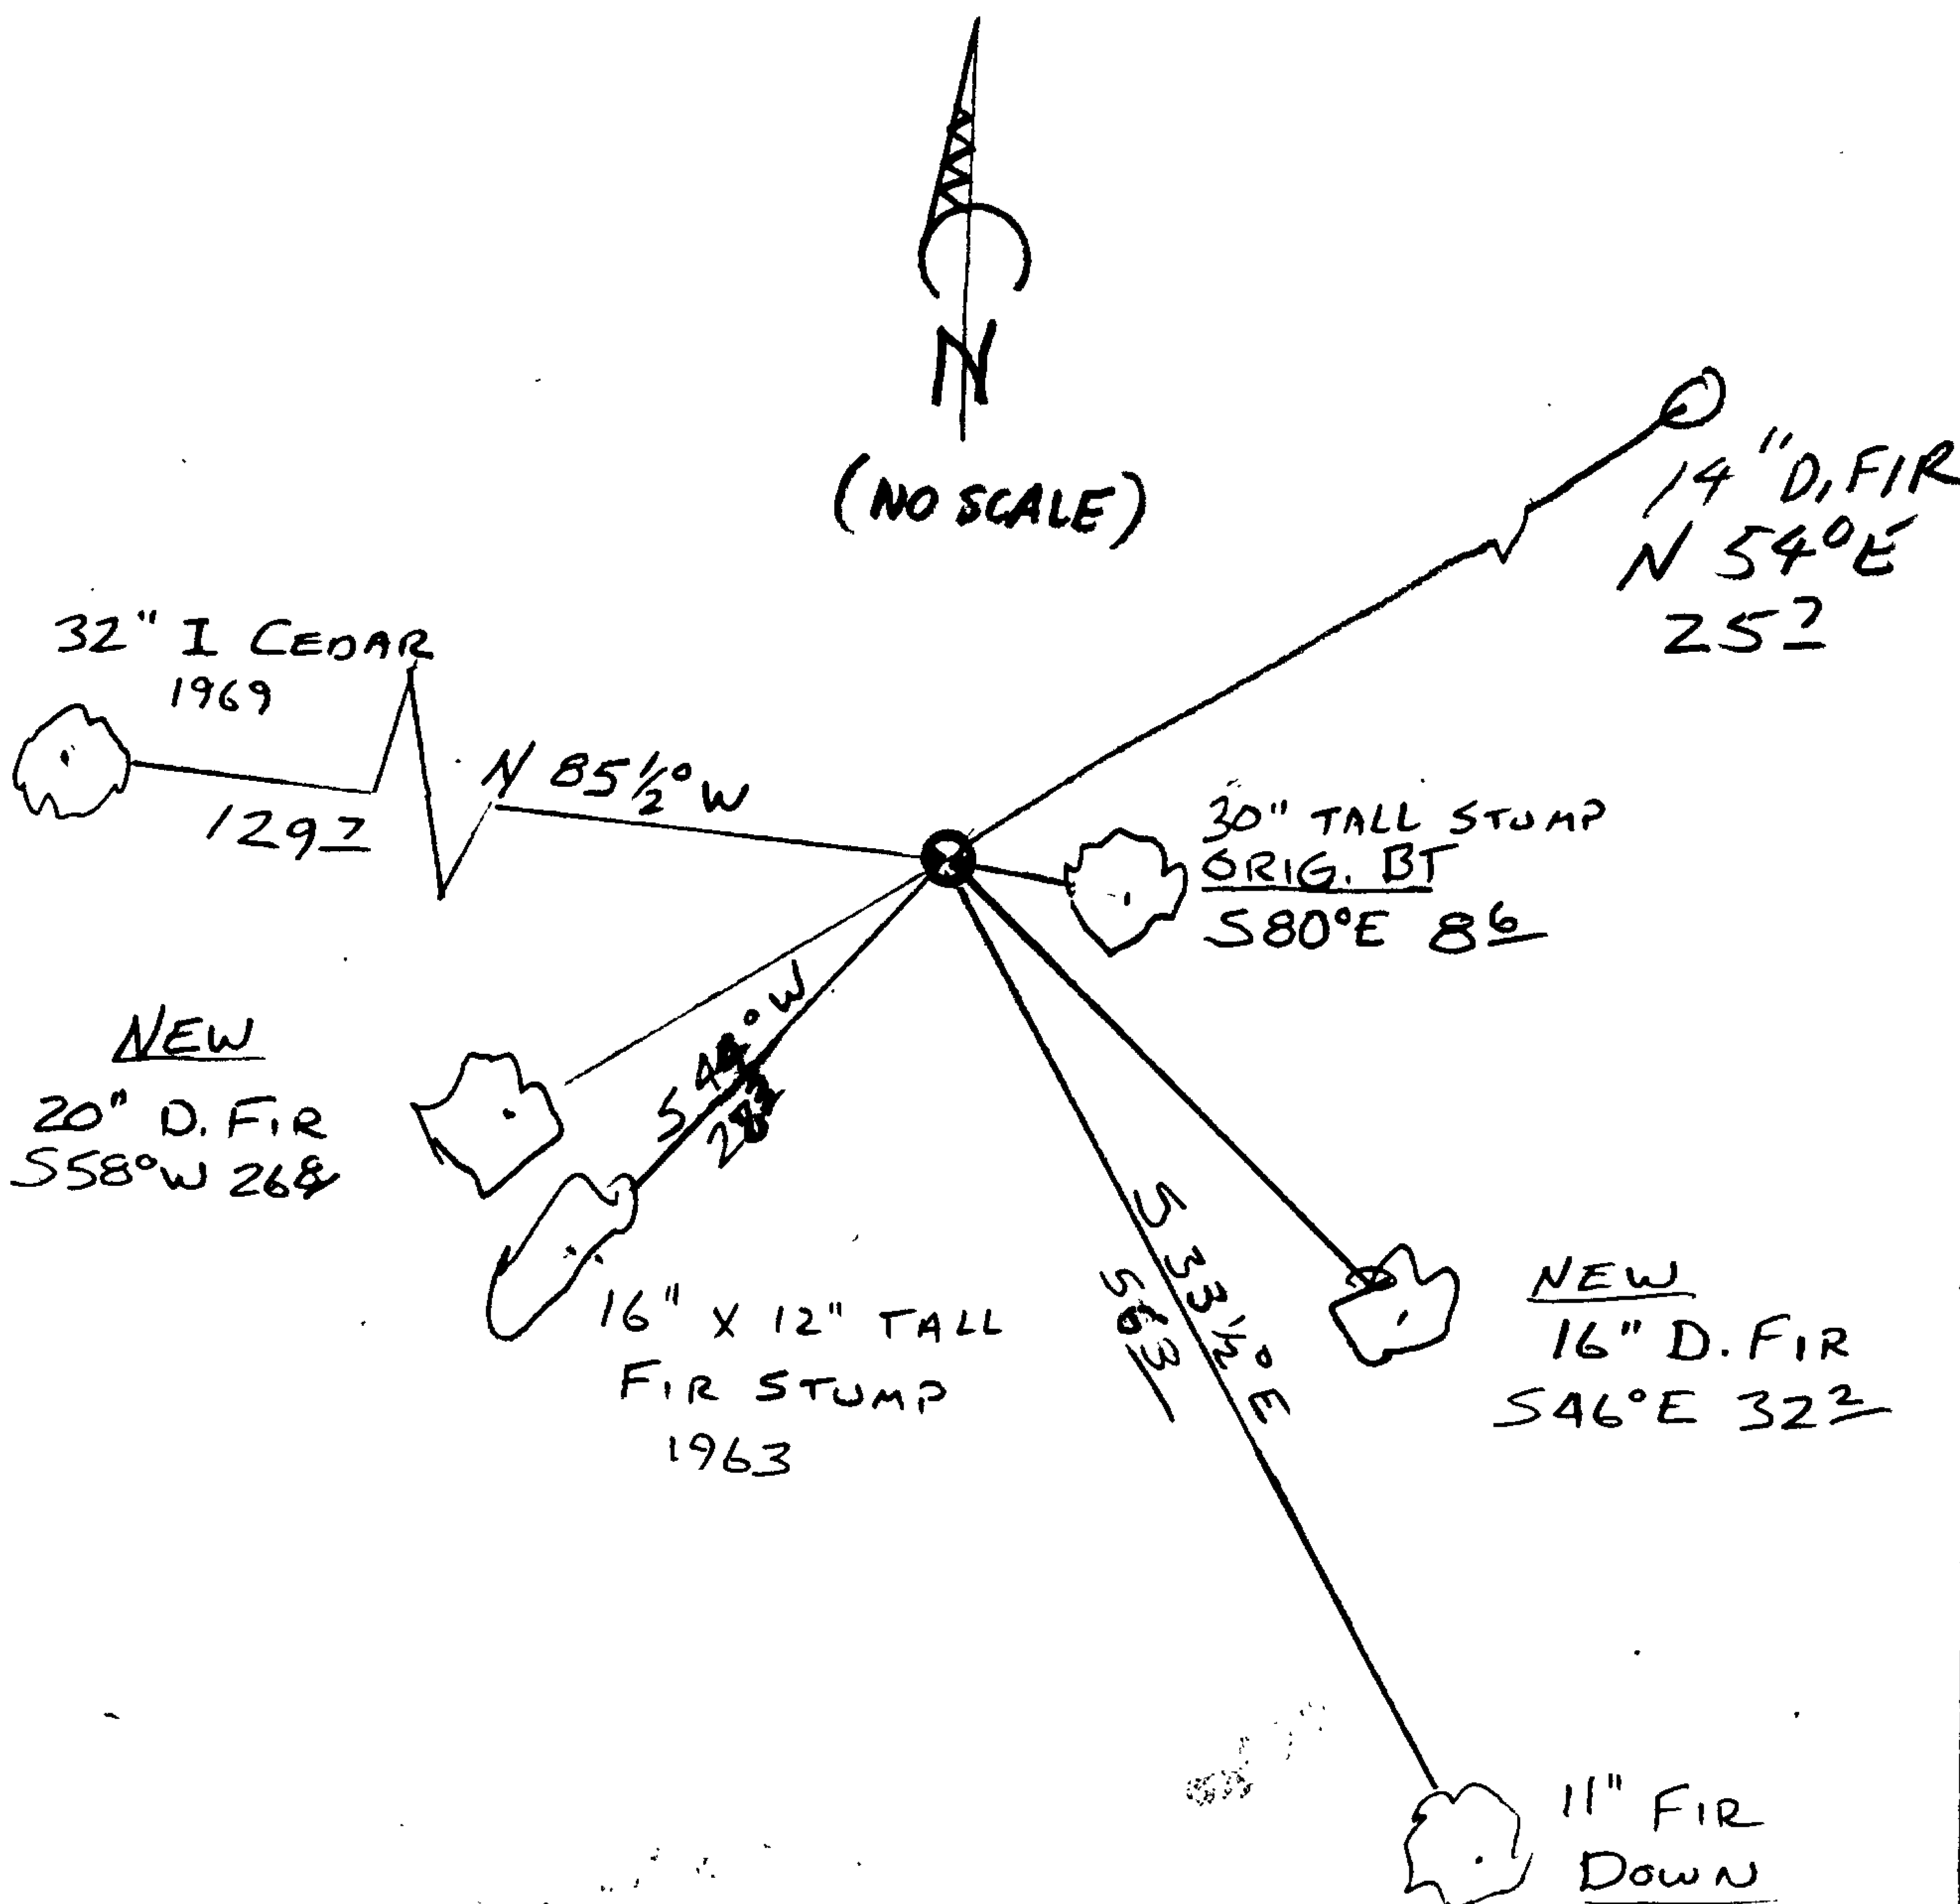

Location & Comments

Comp. Declin. 16 3/4° E
Agency DCSD
Party Chief S.W. FLAUSE
Notekeeper Stephen John Flause
Witnesses J.A. PIKE

Address

