

FILED

GOVERNMENT CORNER RESTORATION FORM

Date: 8-24-2005 By: JC

Township 30 S Range 3 W Sec. 7

County DOUGLAS

This survey consists of:

State OREGON

Date 8-9-05

No. 136600

Corner Rpt. 67/10-43

Corner Designation

NORTH 1/4 COR FOR SEC. 7 ONLY

DOUGLAS COUNTY

SURVEYOR

Condition Report Only

Not Found

Renewed

Unrecorded

Surveyed In


Referenced Out

MONUMENT DETAIL

Previous Renewals

Monument(s) Found: (Condition and Source)

3" B.L.M. BRASS CAP DATED  
1965 APPROX. 2" BELOW  
GROUND.

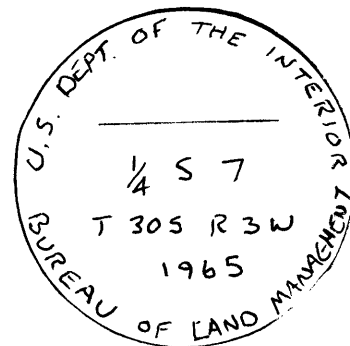

Accessories Found:

- 1" I.D. IRON PIPE PROJECTS 10" ABOVE GROUND BENDS SSW  
APPROX 7" FROM PLUMB POSITION. ALSO LIES APPROX 1 FT.  
WEST OF FENCE CORNER W/FENCES RUNNING SOUTH & WEST.  
BEARS N 87 1/4° W, 125.0 FT. (AGREES WITH RECORD DCSD MAP  
M112-62, ORIG BLM RECORD N 87 1/4° W, 124.0 FT) FROM B. IRVING 1928,  
FROM WHICH IRVINGS BT'S BEAR:
  - 14" Now 25" DIA. W. OAK, FRAG. SCRIBE VISIBLE ON PARTIALLY HEALED BLAZE  
BEARS S 17 1/2° E, 217.14 FT (AGREES W/REC.) 1928 BT
  - 15" Now 25" DIA. W. OAK FULLY HEALED SINGLE BLAZE VISIBLE  
BEARS S 40 3/4° W, 223.74 FT. (AGREES W/REC) 1928 BT
- 20" Now 27" DIA. W. OAK FULLY HEALED DOUBLE BLAZE VISIBLE  
BEARS S 2 1/2° E, 171.4 FT. (AGREES W/REC.) 1965 BT
- NO SIGN OF 1965 LOCUST TREE TO THE WEST

C.S. File No 67/10-43

