

FILED

GOVERNMENT CORNER RESTORATION FORM

Date: 8-24-2005 By: JG

Township 30 S Range 3 W Sec. 6

County DOUGLAS

This survey consists of:

State OR

Date 8-15-2005

No. 140600

Corner Rpt: 67/10-44

Corner Designation

SOUTH 1/4 COR FOR SEC. 6 ONLY

DOUGLAS COUNTY SURVEYOR


- Condition Report Only
- Not Found
- Renewed
- Unrecorded
- Surveyed In
- Referenced Out

MONUMENT DETAIL

Previous Renewals D.C.S.O. 1963

Monument(s) Found: (Condition and Source)

A 1965 DCSO BC PRODUCTS
10" ABOVE GROUND.

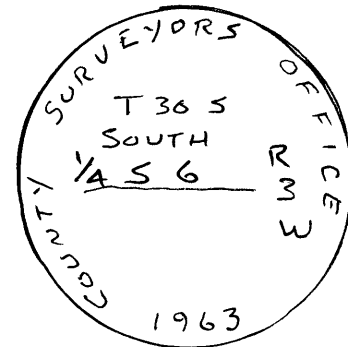

Accessories Found:

- 10" Now 14" W. OAK, FULLY HEALED DOUBLE BLAZE VISIBLE ON MOST WESTERLY TRUNK IN 'CLUMP' OF 3. BEARS S 57 1/2° E, 6 3/4 FT. TO CENTER OF ROOT CROWN (REC'D S 46° E 50 FT) 1963 BT
- 6" Now 7" W. OAK NO MARKS VISIBLE; BEARS N 45° E, 5 3/4 FT. (AGREES W/ REC.) 1928 BT
- 16" Now 21" W. OAK, HEALED SINGLE BLAZE VISIBLE BEARS N 65° W, 7 3/4 FT. (AGREES W/ REC.) 1928 BT

C.S. File No 67/10-44

