

GOVERNMENT CORNER RESTORATION FORM

FILED

Township 22 S Range 12 W Sec. 18

County DOUGLAS Date: 9/23/05 By: JC

State OR Date 9-13-2005

No. 140400 Map: M148-67

Corner Designation

S 1/4 SEC. 18
S 18
S 19

Corner Rpt: 67/13-3


- Condition Report Only
- Not Found
- Renewed
- Unrecorded
- Surveyed In
- Referenced Out

MONUMENT DETAIL

Previous Renewals B. BACON, JUNE 1999

Monument(s) Found: (Condition and Source)

2" O.D. IRON PIPE WITH 2" DIA BRASS CAP SET INTO TOP. PROJECTS 3" FROM SURFACE.

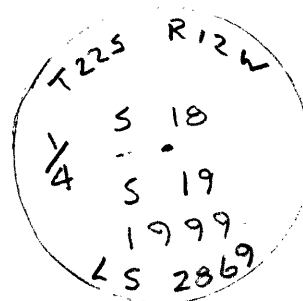

Accessories Found:

16" SPRUCE NOW 16" DIA X 5 FT TALL STUMP UNHEALED SINGLE BLAZE
SCRIBE VISIBLE "1/4 S 19 BT" BEARS S 21°W, 6 1/2 FT.
(AGREES W/RECORD)

15" SPRUCE NOW 17" DIA X 2 FT TALL STUMP UNHEALED SINGLE BLAZE WITH
PARTIAL SCRIBE "S 18 BT" BEARS N 68°E, 3 1/2 FT. (AGREES W/RECORD)

11" SPRUCE NOW 12" DIA X 1 FT TALL STUMP, SCRIBED PORTION
OF TREE IS CUT OFF & LYING BESIDE BEARS N 70°W, 10 3/4 FT.
(AGREES W/RECORD)

18" SPRUCE NOW 18" DIA X 6 FT TALL STUMP, UNHEALED SINGLE BLAZE SCRIBE
"1/4 S 19 BT" VISIBLE BEARS S 55°E, 26 1/2 FT. (AGREES W/RECORD)

C.S. File no 67/13-3

