

GOVERNMENT CORNER RESTORATION FORM

FILED

Date: 10/24/05 By: JC

This survey consists of:

Township 26S Range 21W Sec. 14 County DOUGLAS
 State OREGON Date JAN. 6, 2004 No. 500400 Corner No. 67/13-6

Corner Designation

515	514
522	523

DOUGLAS COUNTY
SURVEYOR

Condition Report Only
 Not Found
 Renewed
 Unrecorded
 Surveyed In
 Referenced Out

Previous Renewals *10 (1957) GOVERNMENT RESURVEYS

Monument(s) Found: (Condition and Source)

1909, 1916, 1957
 MONUMENT DETAIL
 N/A

A GRANITE STONE MEASURING APPROX. 6x10x15 INCHES WITH 2 NOTCHES AND 3 NOTCHES MARKED ON THE APPROPRIATE FACES (1909 GIBB RESURVEY) IS FOUND LOOSE, AND OUT OF POSITION, ON GROUND SURFACE. STONE IS NEAR A HOLE WITH DIMENSIONS SIMILAR TO BASE OF STONE. 1957 DCSO BRASS CAP IS NOT FOUND.

"ACCESSORIES FOUND" BEARINGS AND DISTANCES ARE MEASURED FROM WESTERLY EDGE OF FOUND HOLE; MOST FOUND EVIDENCE INDICATES THIS WAS THE SET POSITION FOR THE 1957 BRASS CAP FROM WHICH THE DCSO, AND 1959 BLM, BEARINGS AND DISTANCES WERE MEASURED. THE FOUND EVIDENCE ALSO INDICATES THE CENTER OF THE FOUND STONE WHEN PROPERLY ORIENTED IN THE ABOVE FOUND HOLE IS ACCESSORIES FOUND: THE CORNER POSITION ESTABLISHED IN 1909 BY GIBB.

ONE ORIGINAL BEARING TREE FOUND; A 12" FIR NOW A 27" DBH D. FIR WITH A FULLY HEALED SINGLE BLAZE BEARS S71 1/2° W, 34 1/2' DISTANT (RECORD S70° W, 35 1/2' DISTANT). POSSIBLE ROOT HOLE OF NW QBT FOUND, NO OTHER ORIGINAL EVIDENCE REMAINS.

FROM THE 1916 MENSCH RESURVEY THREE RENEWAL BEARING TREES ARE FOUND (FOLLOWING 3 BEARINGS AND DISTANCES NOTED AS RECORD WOULD BE TO CENTER OF 1909 STONE MONUMENT)

A 12" FIR NOW A 16" DBH, D. FIR WITH A FULLY HEALED SINGLE BLAZE BEARS N51 1/2° EAST, 42 1/2' DISTANT (RECORD N51 1/2° E, 42 1/2' DISTANT)

A 5" LAUREL NOW A ROTTEN BROKEN MARRONE STUMP (GOOD ROOT POSITION) WITH NO DISCERNIBLE SCRIBING BEARS S34° W, 15 1/2' DISTANT (RECORD S33° W, 16 1/2' DISTANT)

A 18" FIR NOW A 28" DBH, D. FIR WITH A FULLY HEALED SINGLE BLAZE BEARS N70 1/2° W, 49 1/2' DISTANT (RECORD N71° W, 48 1/2' DISTANT)

FROM THE 1957 DCSO RENEWAL ONE RENEWAL BT IS FOUND. A 16" CEDAR NOW A 16" INCENSE CEDAR WITH A FULLY HEALED DOUBLE BLAZE BEARS S1 1/2° E, 128 1/2' DISTANT (RECORD S1° E, 128 1/2' DISTANT)

A BEARING TREE OF UNKNOWN ORIGIN A 17" DBH, D. FIR WITH AN APPARENT FULLY HEALED SINGLE BLAZE (WE DO NOT OPEN) BEARS S35° W, 44 1/2' DISTANT (RECORD ON FOUND BT TAG HAS OPPOSITIVE REVERSE BEARING S35° W AND A DISTANCE OF 67 LINKS; SURVEY ATTRIBUTED TO P.O.P.)

C.S. File No 67/13-6

RENEWAL

Monument Detail

Monument Set (Procedure and Description)

THE PREVIOUSLY DESCRIBED FOUND STONE IS SET IN THE FOUND HOLE WITH 2 NOTCHES ON ONE SIDE FACING EAST AND 3 NOTCHES ON ANOTHER SIDE FACING SOUTH. ALONG THE WEST EDGE OF THE ABOVE STONE IS SET A 2 3/8 INCH DIAMETER BRASS CAP (MARKED AS AT RIGHT) ON A 3/4 INCH GALVANIZED IRON PIPE. THE STONE IS SET WITH ITS TOP FLUSH WITH THE GROUND AND THE BRASS CAP MONUMENT PROTRUDES APPROX. 6 INCHES ABOVE THE GROUND

DOUGLAS COUNTY SURVEYOR
T265 R2W


S15 | 514
S22 | 523

2004

New Accessories

NONE

Sketch of Monument, Accessories, and General Area

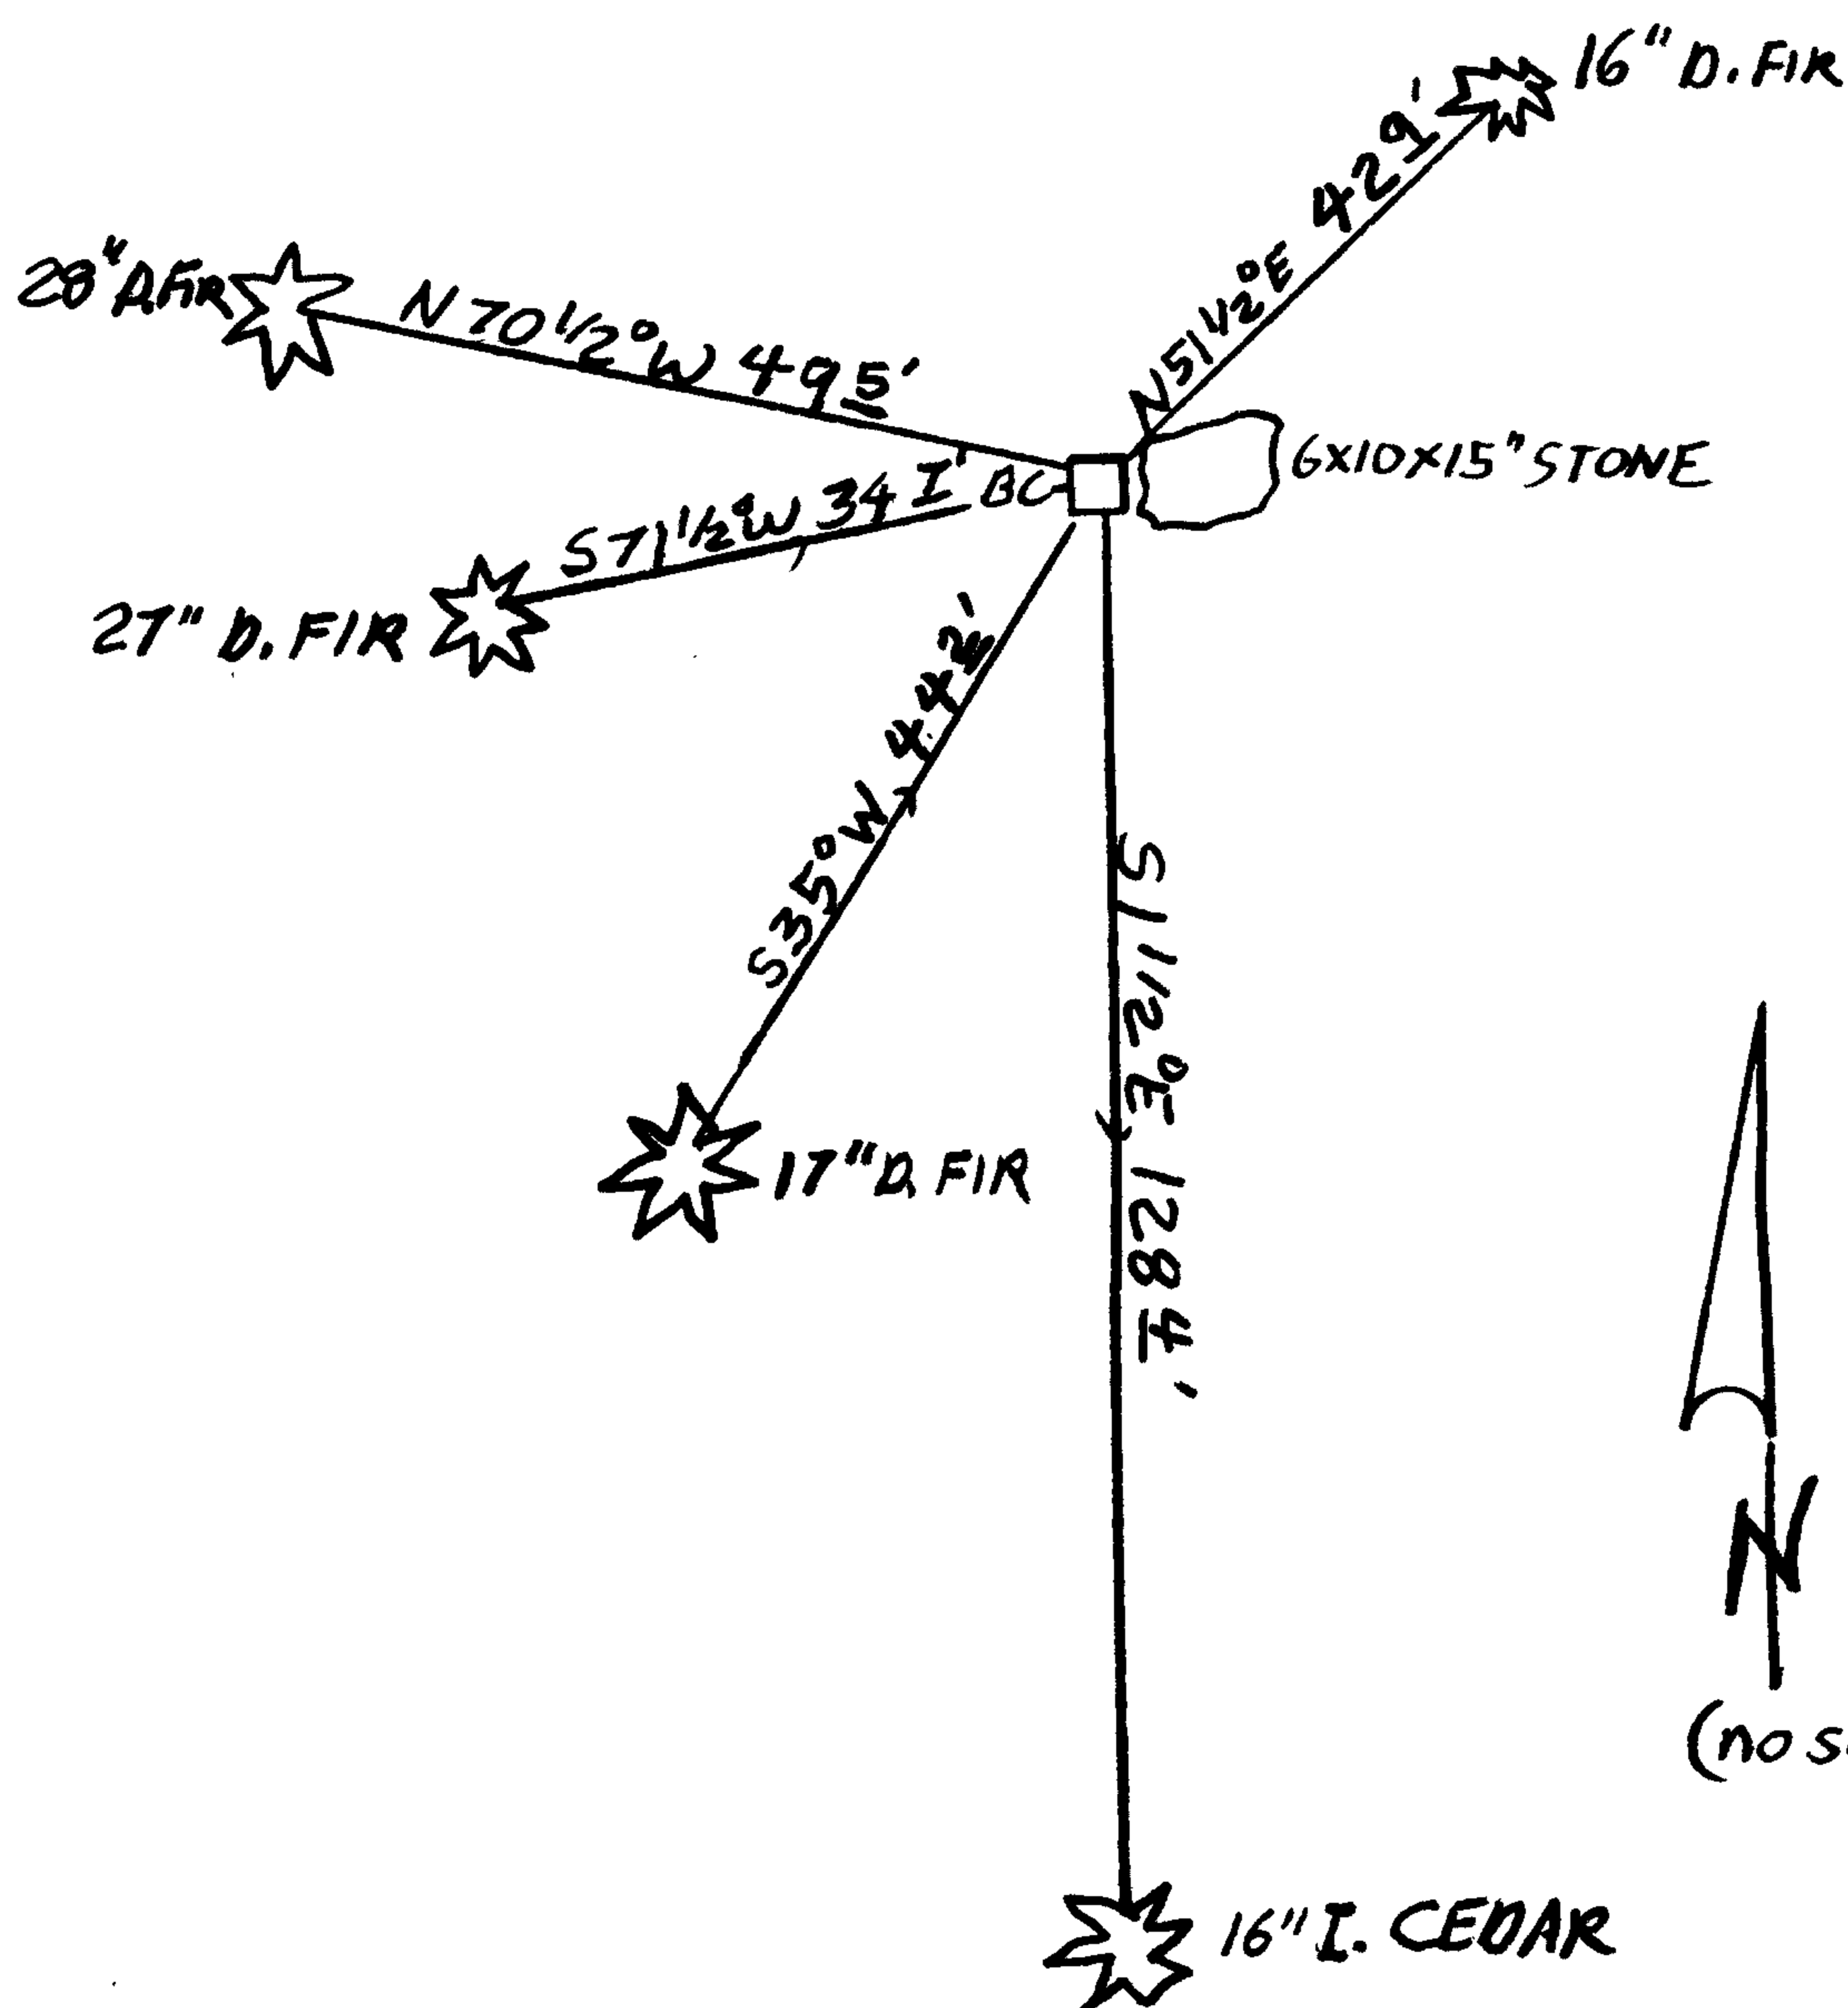

Location & Comments

MONUMENT IS ON GRADUAL SOUTHERLY FACING FORESTED SLOPE.

Comp. Declin. 16 3/4° E
Agency PCSO
Party Chief S.J. FLAUSE
Notekeeper J.A. PIKE
Witnesses Stephen John Flause

Address

Surveyor's Seal

REGISTERED PROFESSIONAL LAND SURVEYOR

Randall W. Smith
6-30-07

OREGON
JULY 25, 1997
RANDALL W. SMITH
2489