

GOVERNMENT CORNER RESTORATION FORM

FILED

Date: 10/24/05 By: J

Township 22 S Range 8 W Sec. 20 County DOUGLAS

This survey consists of:

State OR Date 9-20-05 No. 045060

Map: _____

Narration: _____

Corner File 67/13-7

Corner Designation

NW COR. SAWYER DLC 45

DOUGLAS COUNTY

Condition Report Only

Not Found

Renewed

Unrecorded

Surveyed In


Referenced Out

Previous Renewals BLM 1965

MONUMENT DETAIL

Monument(s) Found: (Condition and Source)

- 27" DIA. DECAYING MAPLE STUMP.
BARK SLABS CUT OFF OF EAST
AND WEST SIDES. 5 FT. TALL

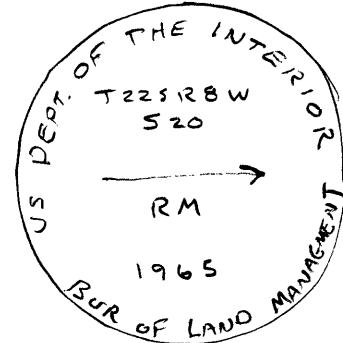

Accessories Found:

- ORIG 6" W. FIR NOW 19" DIA. X 6 FT. TALL STUMP, BARK GONE,
EVIDENCE OF HEALED BLAZE BEARS S70°E, 22 1/2 FT. (AGREES W/REC.)
1965 BT
- REFERENCE MONUMENT, 3" DIA. BRASS CAP ON 2 1/2" DIA. IRON POST. PROJECTS
6" ABOVE GROUND. A 3 FT. TALL FENCE POST WITH BLM TAG
ATTACHED IS DRIVEN NEXT TO BC/IP ON WEST SIDE.
BEARS S76°W, 9 1/2 FT. (AGREES W/REC.) 1965 RM
- NE BT NOT FOUND (REC. N15°E, 35 1/2 FT.) 1965 BT
- ORIG W. FIR BT. NOT FOUND (REC. S4°E, 25 1/2 FT.) 1965 REC.; 1856 BT

C.B. File No 67/13-7

