

FILED

GOVERNMENT CORNER RESTORATION FORM

Date: 10/24/05 By: JK

Township 22 S Range 8 W Sec. 20

County DOUGLAS This survey consists of:

State OR Date 9-20-05

No. 240300 Name of

Corner File 67/13-9

Corner Designation

DOUGLAS COUNTY  
SURVEYOR

South  $\frac{1}{4}$  Sec. 20  $\frac{20}{29}$


- Condition Report Only
- Not Found
- Renewed
- Unrecorded
- Surveyed In
- Referenced Out

MONUMENT DETAIL

Previous Renewals

Monument(s) Found: (Condition and Source)

3" DIA. BRASS CAP (MARKED AS SHOWN)  
PROJECTS 3" ABOVE GROUND.

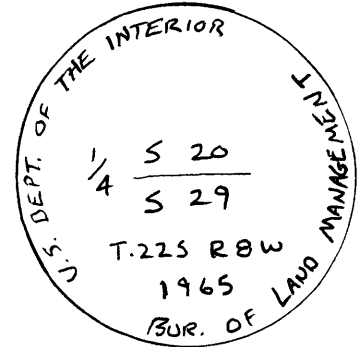

Accessories Found:

ORIG 12" Now 31" DIA. W. FIR, NO BLAZE VISIBLE, BEARS S 19° W, 5 1/2 FT.  
(AGREES W/ RECORD) 1965 BT

ORIG 6" Now 8" DIA. x 1 1/2 FT TALL DECAYED W. OAK STUMP. NO BLAZES  
VISIBLE, BEARS N 16 1/2° E, 35° (REC. N 15° E, 35°) 1965 BT

C.S. File No 67/13-9

