

GOVERNMENT CORNER RESTORATION FORM

FILED

Township 225 Range 8W Sec. 29 County DOUGLAS

Date: 10/24/2005 By: [Signature]

This survey consists of:

State OR Date 9-21-05 No. 045070

Map: \_\_\_\_\_

Native: \_\_\_\_\_

Corner Rpt: 67/13-11

Corner Designation

SW COR J. SAWYER DLC # 45

DOUGLAS COUNTY

Condition:  SURVEYOR Only

Not Found

Renewed

Unrecorded

Surveyed In


Referenced Out

MONUMENT DETAIL

Previous Renewals BLM, 1965

Monument(s) Found: (Condition and Source)

3" BRASS CAP ON 2 1/2" IRON POST  
(MARKED AS SHOWN) PROTECTS FROM  
GROUND 12" ON DOWNHILL SIDE, 3"  
ON UPHILL SIDE.

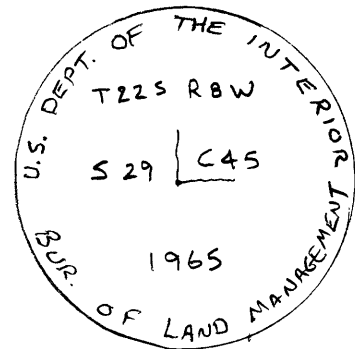

Accessories Found:

~~ORIG~~ 13" Now 26" DIA. HEMLOCK Low HEALED BLAZE VISIBLE  
BEARS N 50° W, 33 7/8 FT. (AGREES W/REC) 1965 BT

~~ORIG~~ 8" Now 16" DIA. X 1 1/2 FT. TALL HEMLOCK STUMP TIPPED OUT  
AND SLID DOWN HILL, EVIDENCE OF LOW BLAZE.  
(REC. N 78 1/2° E, 75 9/16 FT.) 1965 BT

ORIG. MAPLE TREE NOT FOUND (REC. S 65° E, 26 4/5 FT.)

D E G

386

B.S. File No

67/13-11

